


Map No. RJ Sec. 11 Twp. 28 R. 4
Well No. 25 Mayle Farm _____
Empire Company _____
N

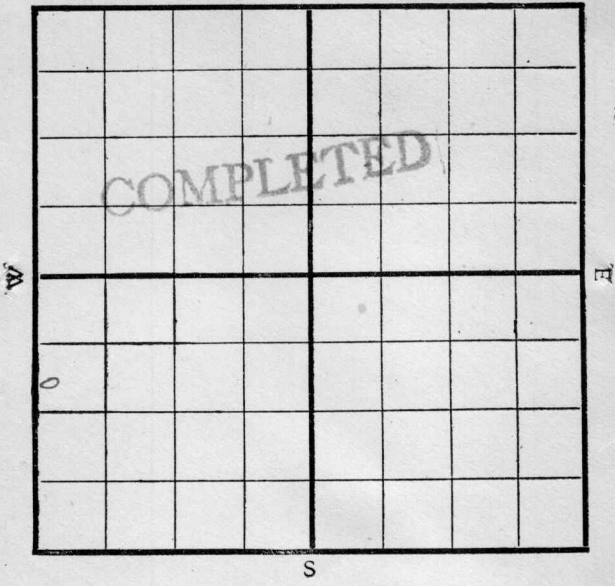

Location _____

Drilling Remarks:

RECORD

Cased _____ in. _____ ft.
Sand _____
Gas _____
Oil _____
Total Depth _____

Rig Up _____

Drilling Remarks:

PRODUCTION

1st 24 hrs. Nat. _____
1st 24 hrs. after shot _____
Gas _____ cu. ft.
Dry Hole _____
Abandoned _____

Map No. _____ Sec. 11 Twp. 28 R. 4Well No. 35 Mayer FarmEngine Company

Contractor

Sec. Quarter990 Ft. from N. Line

Ft. from S. Line

Ft. from E. Line

330 Ft. from W. Line1919
Date

REPORT

11/13 Drill 500 FIRST REPORT
22 Drill for water 1050'
12/11 Drill 1050 for water
2/11 — — — — —
5/16 2566-74 41 lbs. oil
6 lbs. water.

Map No. K11 Sec. 11 Twp. 28 R. 4Well No. 35 MoyerEmpire Company

Contractor

SECTION PLAT

990 Ft. from N. Line

Ft. from S. Line

Ft. from E. Line

330 Ft. from W. Line

FIRST REPORT

Location

Rig up

Drilling and Remarks:

500

RECORD

Cased _____ in., _____ ft.

Sand _____

Gas _____

Oil _____

Total Depth _____

PRODUCTION

1st 24 hrs. Nat. _____

1st 24 hrs. after shot _____

Gas _____ Cu. Ft.

Dry Hole _____

Abandoned _____

Date

11/13 1919

Scout

Pyle

Map No. K 11 Sec. 11 Twp. 28 R. 4

Well No. 35 Mayle

Empire Company

Contractor

SECTION PLAT

990 Ft. from N. Line

_____ Ft. from S. Line

_____ Ft. from E. Line

330 Ft. from W. Line

COMPLETED

Location _____

Rig up _____

Drilling and Remarks:

41 bbls Oil
6 bbls water

RECORD

Cased _____ in., _____ ft.

Sand 2566-74

Gas _____

Oil _____

Total Depth _____

PRODUCTION

1st 24 hrs. Nat. _____

1st 24 hrs. after shot _____

Gas _____ Cu. Ft.

Dry Hole _____

Abandoned _____

Date

5/26 1920

Pyle

Scout