

Map No. _____ Sec. 11 Twp. 28 R. 4Well No. 18 Moyle Farm __________Empire Company _____

NORTH

WEST

EAST

SOUTH

Location _____

Rig Up _____

Drilling Remarks:

Drilling Remarks:

RECORD

Cased _____ in. _____ ft.

Sand _____

Gas _____

Oil _____

Total Depth _____

PRODUCTION

1st 24 hrs. Nat. _____

1st 24 hrs. after shot _____

Gas _____ cu. ft

Dry Hole _____


Abandoned _____

Map No. _____ Sec. 11 Twp. 28 R. 4
 Well No. 18 Maylee Farm _____
Emery Company _____

NORTH

WEST

EAST

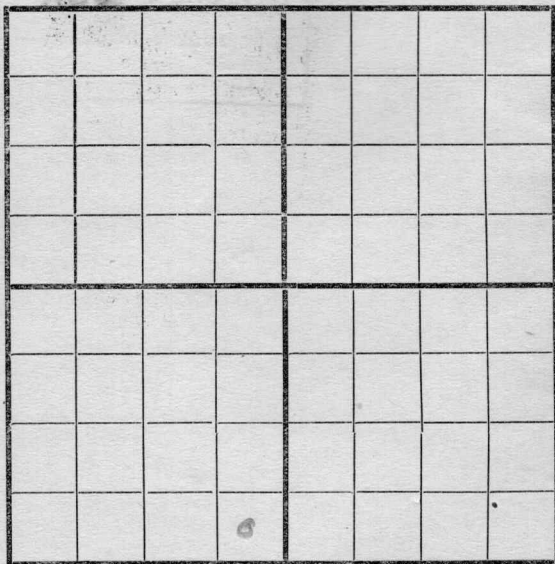

SOUTH

Location _____
 Rig Up _____
 Drilling and remarks _____

RECORD

Cased _____ in. _____ Ft.
 Sand _____
 Gas _____
 Oil _____
 Total Depth _____

PRODUCTION

1st 24 hrs. Nat. _____
 1st 24 hrs. after shot _____
 Gas _____ Cu. Ft.
 Dry Hole _____
 Abandoned _____

NEW LOCATION

Date

MAR 24 1917


191

C. J. Crocker
Emery Scout

Map No. _____ Sec. 11 Twp. 28 R. 4Well No. 18. Moyle Farm _____Compu Company _____

NORTH

WEST

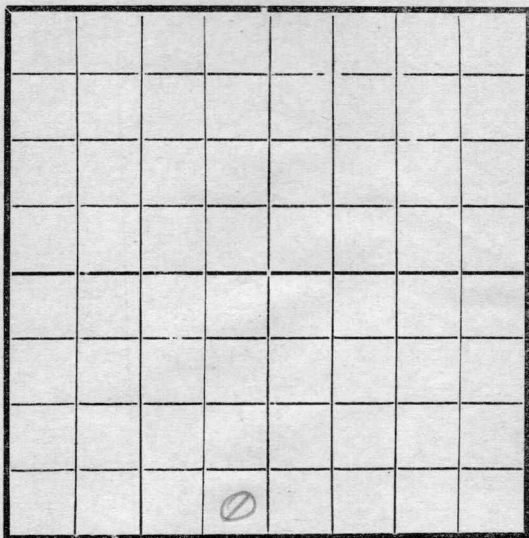

EAST

SOUTH

Location _____

Rig Up _____

Drilling and remarks

at 3leo

RECORD

Cased _____ in. _____ Ft.

Sand _____

Gas _____

Oil _____

Total Depth _____

PRODUCTION

1st 24 hrs. Nat. _____

1st 24 hrs. after shot _____

Gas _____ Cu. Ft.

Dry Hole _____

Abandoned _____


Date

8-21, 1917 Lantz Scout

Map No. _____ Sec. 11 Twp. 28 R. 4Well No. 18 Maylee Farm __________
Company _____

NORTH

WEST

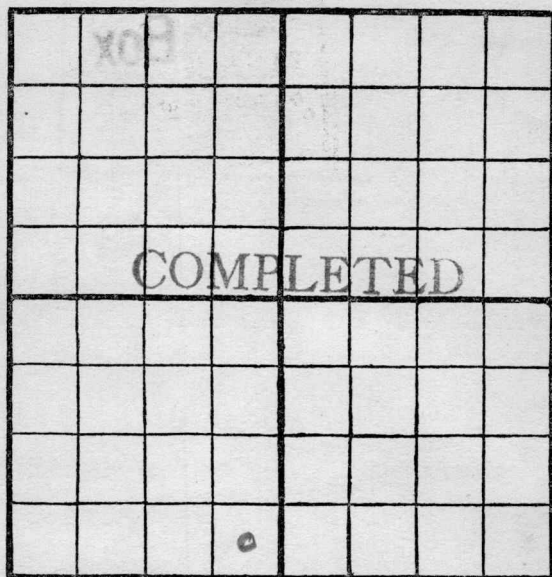

EAST

SOUTH

Location _____

Rig Up _____

Drilling and remarks

Est at
50 Bbl

RECORD

Cased _____ in. _____ Ft.

Sand 2630-2640

Gas _____

Oil _____

Total Depth _____

PRODUCTION

1st 24 hrs. Nat. _____

1st 24 hrs. after shot _____

Gas _____ Cu. Ft.

Dry Hole _____

Abandoned _____

Date

10/2, 1912, 2 Canby Scout