


Map No. _____ Sec. 11 Twp. 28 R. 4
 Well No. 31 Moyle Farm _____
Empire Company _____

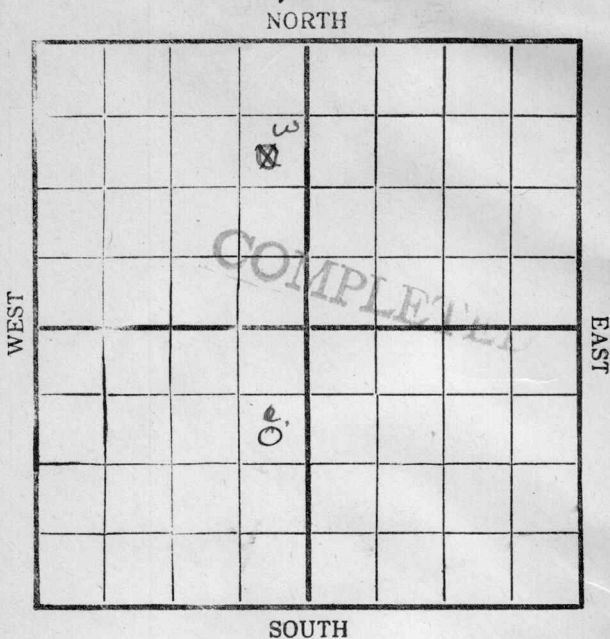

Location _____

Rig Up _____

Drilling Remarks:

Drilling Remarks:

RECORD

PRODUCTION

Cased _____ in. _____ ft.

1st 24 hrs. Nat. _____

Sand _____

1st 24 hrs. after shot _____

Gas _____

Gas _____ cu. ft.

Oil _____

Dry Hole _____

Total Depth _____

Abandoned _____

Map No. K 11 Sec. 11 Twp. 28 R. 4

Well No. 31 Moyle


Empire Company

Contractor

NORTH

WEST

EAST

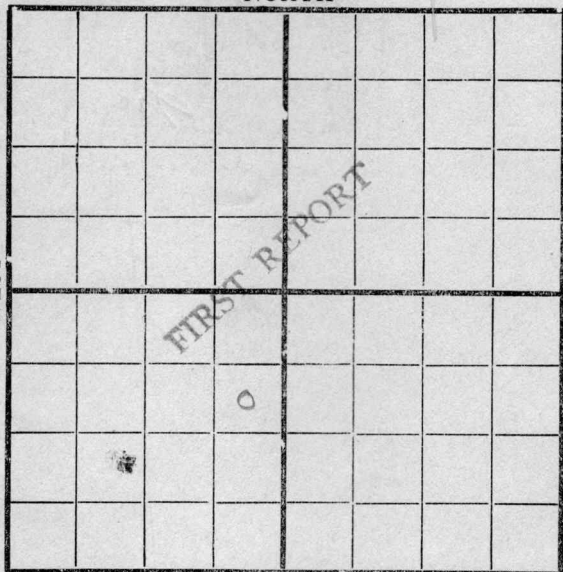

990 N

SOUTH

330 E

Location

Rig up

Drilling and Remarks:

RECORD

Cased.....in.,ft.

Sand.....

Gas.....

Oil.....

Total Depth.....

PRODUCTION

1st 24 hrs. Nat.....

1st 24 hrs. after shot.....

Gas.....Cu. Ft.

Dry Hole.....

Abandoned.....


Date

7/6 1919 Moyle Scout

Sec. 11 Twp. 28 Rge. 4
Owner Empire
Farm Moyle Well No. 31
Contractor _____

Feet from lines, N. 990 E. 330 S. _____ W. _____

Casing used _____
15 1/2 _____ ft.
12 1/2 _____ ft.
10 _____ ft.
8 1/4 _____ ft.
6 5/8 _____ ft.
5 3-16 _____ ft.
Location _____
Rig _____

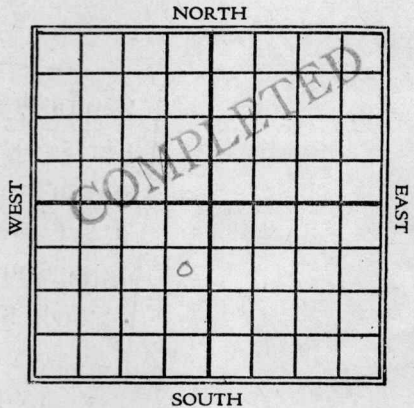

Drilling at _____ ft. Fishing at _____ ft.
Total Depth _____ Completed _____
1st 24 Hrs. Nat. _____ Producing _____
1st 24 Hrs. Shot _____ Dry Hole _____
Gas _____ Cu. ft. Abandoned _____
Sands — give name and depth. Top 2583 Bottom 2609

60 bbls 1st 10 hrs

Date of Report 7/22
Reported by Pyle