

Well No. 2-7 Coll Farm
Foster, Cal Company

WEST

EAST

SOUTH

Drilling Remarks

Drilling Remarks

Total Depth_____

Abandoned _____


Map No. **KANSAS** Sec. 7 Twp. 24 R. 12
Well No. 2-Scott Farm
Foster Ber Company

_____ Ft. from N. Line

1020 Ft. from S. Line

_____ Ft. from E. Line

760 Ft. from W. Line

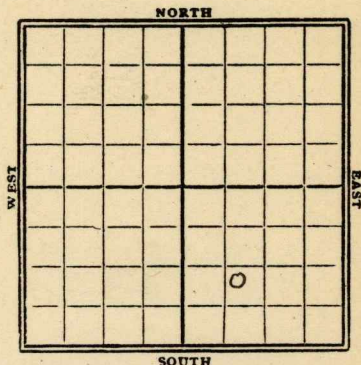

Date

REPORT

7/17 sdy shale 1560-78
show oil
Top line 1802-25
Oil & water
Testing T.D. 1825'
7/24 S.S. 1560-78' show
Top line 1802-25
T.D. 1829
P.B. to 1825
20 bbl oil
20 " water
Pump.

Greenwood

KANSAS

Map No. _____ Sec. 7 Twp. 74 R. 12 ^EWell No. 2 ScottFoster et al Company

Contractor

FIRST REPORTS

_____ Ft. from N. Line

1020 Ft. from S. Line

_____ Ft. from E. Line

760 Ft. from W. Line

SECTION PLAT

		0	

Location _____

Rig up _____

Drilling and Remarks:

Sandy shale 1560-78'

Show oil.

Tap line 1802-1875'

oil & water.

Testing.

RECORD

Cased _____ in., _____ ft.

Sand _____

Gas _____

Oil _____

Total Depth 1875

PRODUCTION

1st 24 hrs. Nat. _____

1st 24 hrs. after shot _____

Gas _____ Cu. Ft.

Dry Hole _____

Abandoned _____

Date

JUL 17 1929

CHAS. L. SHERWOOD

19

Scout

Greenwood
 Map No. **KANSAS** Sec. *7* Twp. *24* R. *12*
 Well No. *2 Scott*
Foster & Co Company

Contractor

COMPLETE**SECTION PLAT**

Ft. from N. Line

1020 Ft. from S. Line

Ft. from E. Line

760 Ft. from W. Line

		0	

Location

RECORD

Rig up

Drilling and Remarks:

*SS 1560-78 show**PB to 1825'**20 Bbl oil**20 Bbl water*Cased *top line* in., ft.Sand *1802-1825*

Gas

Oil

Total Depth *1829***PRODUCTION**

1st 24 hrs. Nat.

1st 24 hrs. after shot

Gas Cu. Ft.

Dry Hole

Abandoned

Date

*JUL 24 1929***CHAS. L. SHERWOOD**