

Well No. 1 Thrall Farm

well No. 1 Acacia Farm
~~Charles~~ Company

Tanson oil corp.

WEST

EAST

SOUTH

Q

Rig Up.....

Drilling Remarks

PRODUCTION

1st 24 hrs. Nat.

1st 24 hrs. after shot.....

Gas..... cu. ft.

Dry Hole.....

Abandoned

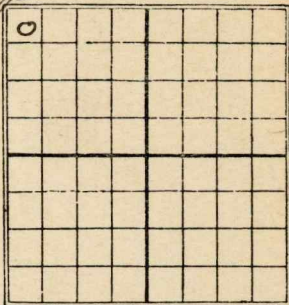
Map No. _____ Sec. 7 Twp. 24 R. 12Well No. 1-Thrall Farm~~Sharpless & Co~~ Company
Kanson oil corp.

NORTH

WEST

EAST

SOUTH

330 Ft. from N. Line

_____ Ft. from S. Line

_____ Ft. from E. Line

330 Ft. from W. Line1927

Date

REPORT

2/16 Location2/24 —3/2 —3/9 —3/16 —3/24 —3/30 —4/7 —4/13 —4/20 —4/27 —5/5 Machine5/12 Setting 10"-7105/25 Abandoned 1828

Sherwood

16 KANSAS
Map No. _____ Sec. 7 Twp. 24 R. 12
Well No. 1 Thrall
Sharpless et al Company

Contractor

FIRST REPORTS

SECTION PLAT

330 Ft. from N. Line
____ Ft. from S. Line
____ Ft. from E. Line
330 Ft. from W. Line

0			

Location ✓
Rig up
Drilling and Remarks:

RECORD

Cased _____ in., _____ ft.
Sand _____
Gas _____
Oil _____
Total Depth _____

PRODUCTION

1st 24 hrs. Nat. _____
1st 24 hrs. after shot _____
Gas _____ Cu. Ft.
Dry Hole _____
Abandoned _____

Date FEB 16 1927
192 _____ Scout
CHAS. L. SHERWOOD

16 **KANSAS** *Sherwood*
 Map No. _____ Sec. *7* Twp. *24* R. *12*
 Well No. *1* *Shale*

Kan Son Oil Corp Company
 _____ Contractor

CORRECTION**SECTION PLAT**

330 Ft. from N. Line

_____ Ft. from S. Line

_____ Ft. from E. Line

330 Ft. from W. Line

o			

Location ☒

Rig up _____

Drilling and Remarks:

Chg Ownership

RECORD

Cased _____ in., _____ ft.

Sand _____

Gas _____

Oil _____

Total Depth _____

PRODUCTION

1st 24 hrs. Nat. _____

1st 24 hrs. after shot _____

Gas _____ Cu. Ft.

Dry Hole _____

Abandoned _____

Date

APR 13 1927

CHAS. L. SHERWOOD

192

Scout

Shenwood
16 KANSAS
 Map No. _____ Sec. *7* Twp. *24* R. *12*
 Well No. *1* *Thrace*
Benson Oil Corp Company
 _____ Contractor

COMPLETED

SECTION PLAT

330 Ft. from N. Line

_____ Ft. from S. Line

_____ Ft. from E. Line

330 Ft. from W. Line

<i>0</i>			

ABANDONED

Location _____

Rig up _____

Drilling and Remarks:

Sand 1593-1600'

Top line 1790'

Oil 1828' Air

RECORD

Cased _____ in., _____ ft.

Sand _____

Gas _____

Oil _____

Total Depth *1828'*

PRODUCTION

1st 24 hrs. Nat. _____

1st 24 hrs. after shot _____

Gas _____ Cu. Ft.

Dry Hole ☒ _____

Abandoned ☒ _____

Date

MAY 25 1927

CHAS. L. SHERWOOD

192

Scout