


Section 7 Township 24 Range 12EWell No. #1 UlrichCompany ~~C. E. Miller~~ H. Ulrich

NORTH

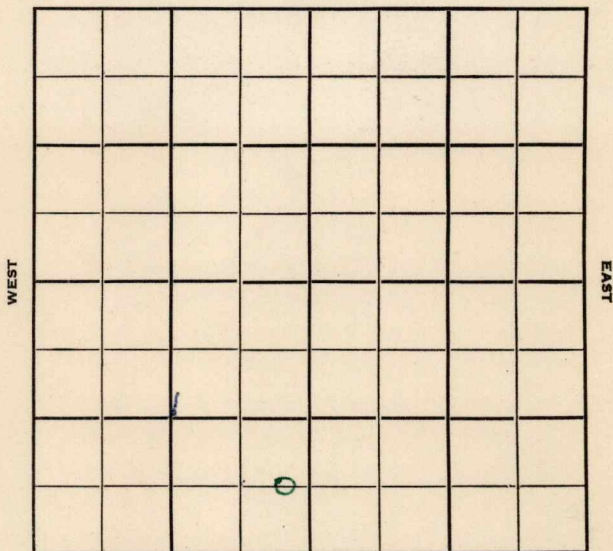

SOUTH

Greenwood

KANSAS ✓

Sec. 7 Twp. 24 R. 12E

Well No. #1 Ulrich Farm

C. E. Miller Company

Hamilton Pool


Ft. from N. Line

660' Ft. from S. Line

330' Ft. from E. Line

Ft. from W. Line

E/2 SE SW

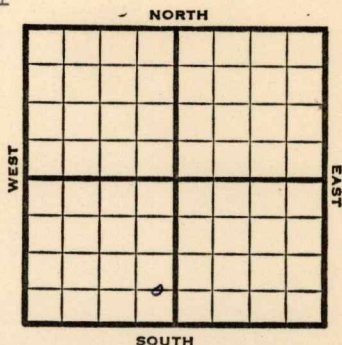

1951

Elev. -

REPORT

11/14

8" @ 54'

Miss 1804

RTD 1812

4 1/2" @ 1805'

11/28

Oil Well TD 1824

8" @ 54'

Miss 1804

4 1/2" @ 1805

TD 1824

FU 1200' oil overnite

Comp. 15 bopd

COMPLETED

County Greenwood

Elev. _____

Sec. 7Twp. 24Rgs. 12ECompany H. UlrichFarm Name UlrichNo. 1

TOPS	DEPTH	LOG	DATUM	Loc. in Sec.
Anh.				C E/2 SE SW
Tr.				(OWDD) was
Dg.	1590			SE SW SW
Bl.				
L.				Geol.
M.C.				Contr.
B.K.C.				
Ce.				
C.				
M.				Pool
M.				
K.				
Mz.				
Mo.				
V.				
S.				
S.				
A.				
R.				
Pe.				
G.				
TD	1620			

MAY 15 1957

COMPLETE

Date Comm. 1590-1600 w/ss0


Was D & A

New Info. - RURT dd, Miss chert 1800,

Miss lm 1813, RTD 1821 w/so, 5" @ 1820/50

WOC MAY 8 57 RUCT MAY 15 57 DD 1822

P. 12 Bopd no / w/t

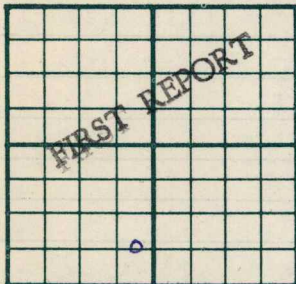County Greenwood State KansasSec. 7 (Blk. 24 (Sur. 12E Map No. 12E)
(Twp.) (Rge.)Operator C. E. MillerWell No. 1 Farm UlrichElev. _____ Location E/2 SE SW660 Ft. From S Line SW330 Ft. From E Line Quarter1st. Report NOV 14 1951

Completion _____

Remarks _____

Spudding Date _____

Drlg. Data Hamilton Pool8" @ 54 Miss 1804 RTD 1812 4 1/2" @ 1805J. E. TYRA

County Greenwood State Kansas
 Sec. 7 (Blk.) 24 (Sur.) 12E Map No.
 Operator C. E. Miller
 Well No. 1 Farm Ulrich
 Elev. Location C E L SE SW



660 Ft. From S Line SW
330 Ft. From E Line Quarter
 1st. Report
 Completion NOV 28 1951
 Remarks Hamilton Pool
 Spudding Date

Drlg. Data Oil well TD 1824
8" @ 54 Miss. 1804 4½" @ 1805 TD 1824
FU 1200' oil overnite Comp. 15 bopd

J. E. TYRA

O. W. D. D.

FORM 513 SUNRAY

County Greenwood Elev. _____
 Sec. 7 Twp. 24 Rge. 12E
 Company H. Ulrich
 Farm Name Ulrich No. 1

TOPS	DEPTH	LOG	DATUM	Loc. in Sec.
Anh.				C E/2 SE SW
Tr.				
H.				(OWDD) was
Tr. <u>ct1 sd</u>	<u>1590</u>			SE SW SW
Dg.				
Bl.				Geol. _____
L.				Contr. _____
K.C.				
B.K.C.				
Ce.				
C.				
M.				
M.				Pool _____
K.				
Mz.				
Mq.				
V.				
S.				
S.				
A.				
R.				
Pe.				
G.				
TD. <u>OTD</u>	<u>1620</u>			

FIRST-REPORT

Date Comm. 1590-1600 w/ss0
Was D & A
 New Info. - RURT dd, Miss chert 1800,
 Miss lm 1813, RTD 1821 w/so, 5" @ 1820/50
 WOC