


Section 11 Township 28 Range 4EWell No. #1 Moyle "B"Company H & M Drlg.

NORTH

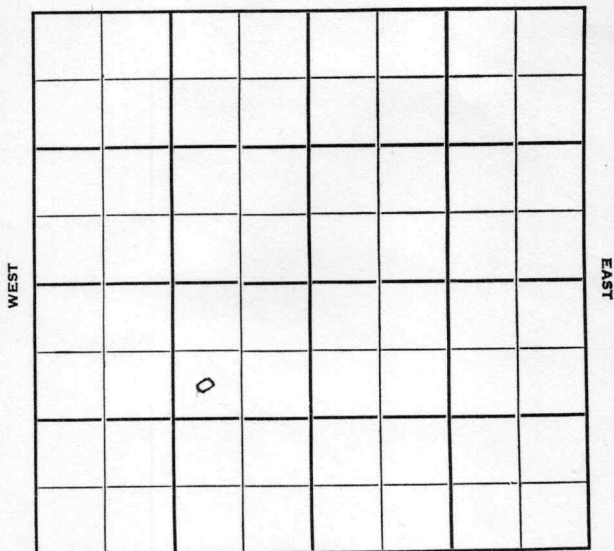

SOUTH

Butler

KANSAS

Sec. 11 Twp. 28 R. 4E ✓

Well No. #1 Moyle "B" Farm

H & M Drlg. Company


Contractor

990' Ft. from N. Line

_____ Ft. from S. Line

990' Ft. from E. Line

_____ Ft. from W. Line

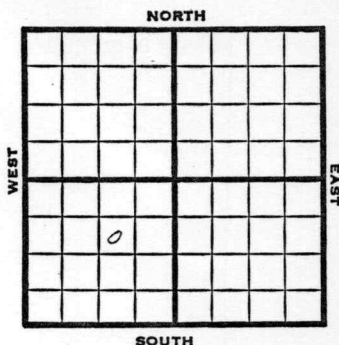

SW NE SW

1951

Elev. 1275'

REPORT

5/2 Set surface
6/20 Spud 5-19-51 Oil well TD 2586'
10" @ 65 KC 2058' Simp. 2530-38'
7" @ 2530' TD 2586' HFW PB 2098'
60/2057-75 3000 A
Comp. 30 BOPD

COMPLETED

County Butler State KansasSec. 11 (Blk.) 28 (Sur.) 4E Map No.Operator H & M Drlg.Well No. 1 Farm Moyle "B"Elev. Location SW NE SW

FIRST REPORT

0

990 Ft. From N Line SW990 Ft. From E Line Quarter1st. Report MAY 2 1951

Completion


Remarks

Spudding Date

Drlg. Data

Set surface

J. E. TYRA

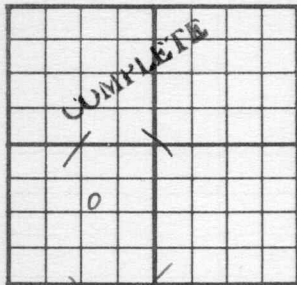County Butler State KansasSec. 11 (Blk.
Twps.) 28 (Sur.
Rge.) 4E Map No.Operator H & M Drlg.Well No. 1 Farm Moyle "B"Elev. 1275 Location SW NE SW990 Ft. From N Line SW990 Ft. From E Line Quarter

1st. Report _____

Completion JUN 20 1951

Remarks _____

Spudding Date 5-19-51Drlg. Data Oil well TD 258610" @ 65 KC 2058 Simp. 2530-387" @ 2530 TD 2586 HFW PB 209860/ 2057-75 3000 A Comp. 30 bopd

J. E. TYRA