

Map No. Kansas Sec. 7 Twp. 24 R. 12

Well No. 2 Thrall Farm

Enterprise Dev Company

NORTH

WEST

EAST

SOUTH

LOG

Location _____

Drilling Remarks

Rig Up _____

Drilling Remarks

RECORD

Cased _____ in. _____ ft.

Sand _____

Gas _____

Oil _____

Total Depth _____

PRODUCTION

1st 24 hrs. Nat. _____

1st 24 hrs. after shot _____


Gas _____ cu. ft.

Dry Hole _____

Abandoned _____

Map No. Kansas Sec. 7 Twp. 24 R. 12Well No. 2 Thrall FarmEnterprise Seo Company

NORTH

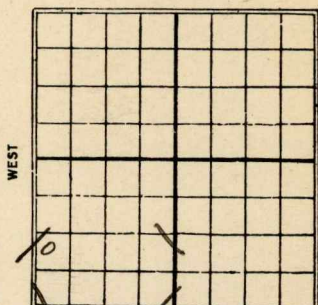

Ft. from N. Line

1070 Ft. from S. Line

Ft. from E. Line

250 Ft. from W. Line

Date

REPORT

<u>1926</u>	
<u>5/26</u>	<u>Machine</u>
<u>6/2</u>	<u>Spudg. 180'</u>
<u>6/10</u>	<u>Drly. 640</u>
<u>6/18</u>	<u>" 830</u>
<u>6/25</u>	<u>" 1645</u>
<u>6-30</u>	<u>8/0 1755</u>
<u>7/18</u>	<u>top line 1816' shale</u>
	<u>brk 1837-43 - S.D. 1840</u>
<u>7/14</u>	<u>T.D. 1840 - D & F 1840</u>
	<u>top line 1816 - Shale</u>
	<u>break 1837-1843</u>
	<u>D. & F. 1840</u>

Sherwood
 K16 KANSAS
 Map No. _____ Sec. *7* Twp. *24* R. *12*
 Well No. *2* *Shall*
Enterprise Dev Co Company

Contractor

FIRST REPORTS

SECTION PLAT

_____ Ft. from N. Line

1070 _____ Ft. from S. Line

_____ Ft. from E. Line

250 _____ Ft. from W. Line

Location _____

Rig up *Machine* _____

Drilling and Remarks:

RECORD

Cased _____ in., _____ ft.

Sand _____

Gas _____

Oil _____

Total Depth _____

PRODUCTION

1st 24 hrs. Nat. _____

1st 24 hrs. after shot. _____

Gas _____ Cu. Ft.

Dry Hole _____

Abandoned _____

Date

MAY 26 1926

CHAS. L. SHERWOOD

192

Scout

Greenwood
 K16 **KANSAS**
 Map No. _____ Sec. *7* Twp. *24* R. *12*
 Well No. *2 shale*

Condon Prod Dev Co Company

Contractor

COMPLETED

SECTION PLAT

_____ Ft. from N. Line

1070 _____ Ft. from S. Line

_____ Ft. from E. Line

250 _____ Ft. from W. Line

ABANDONED

<i>10</i>			

Location _____

Rig up _____

Drilling and Remarks:

Top line 1816'
shale break 1837'
1843'

1844 1840'

RECORD

Cased _____ in., _____ ft.

Sand _____

Gas _____

Oil _____

Total Depth *1840'*

PRODUCTION

1st 24 hrs. Nat. _____

1st 24 hrs. after shot _____

Gas _____ Cu. Ft.

Dry Hole ☒

Abandoned ☒

Date

JUL 14 1906

_____ 192 _____

CHAS. L. SHERWOOD

_____ Scout