

Greenwood

DX 78-1


KANSAS

Section 7 Township 24 Range 12E

Well No. #2 Ulrich

Company Baker & Ulrich

NORTH

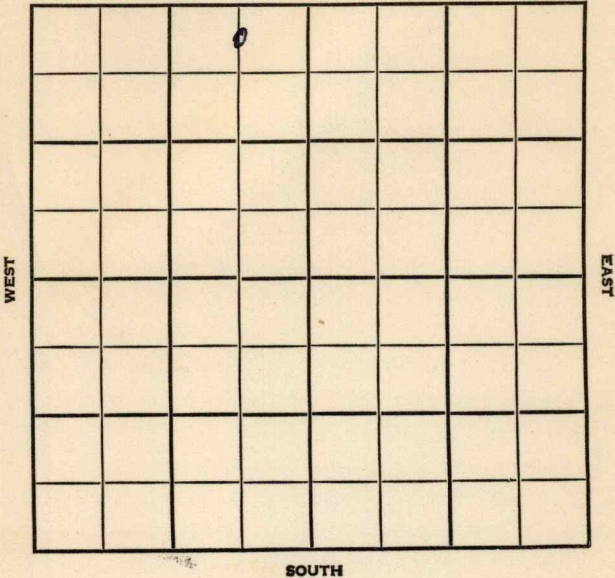

Greenwood KANSAS

SEC.	TWP.	R.
7	24	12E

WELL NO.

2 Ulrich FARM

COMPANY

Baker & Ulrich

CONTRACTOR

Baker
Hamilton Pool


330 Ft. from N. Line

Ft. from S. Line

660 Ft. from E. Line

Ft. from W. Line

C N/2 NE NW

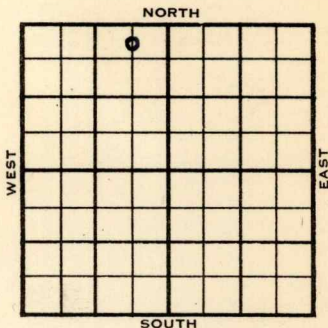

	ELEVATION	REPORT
--	-----------	--------

1955

1/19

Spud 1-10-55
8" @ 673'
Drlg. 730'

3/23

Spud 1-10-55, Oil Well, TD 1782
8" @ 673, 7" @ 1296, Miss 1780
TD 1782, 5" @ 1708, CO to 1782
500 A P/150 B0 12 hr
Comp 20 bopd

COMPLETED

County Greenwood State KansasSec. 7 (Blk.) 24 (Sur.) 12E Map No.Operator Baker & UlrichWell No. 2 Farm UlrichElev. Location C N $\frac{1}{2}$ NE NW


330 Ft. From N Line NW660 Ft. From E Line Quarter1st. Report JAN 19 1955

Completion

Remarks

Baker - Contr.Spudding Date 1-10-55Drlg. Data Hamilton Pool8" @ 673 drlg. 730

FABEN GILSTRAP

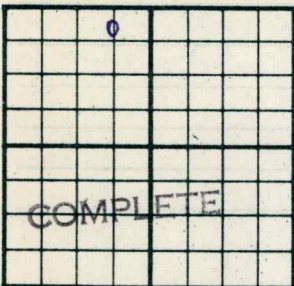County Greenwood State KansasSec. 7 (Blk. Twp.) 24 (Sur. Rge.) 12E Map No.Operator Baker & UlrichWell No. 2 Farm UlrichElev. Location C N $\frac{1}{2}$ NE NW330 Ft. From N Line NW660 Ft. From E Line Quarter

1st. Report

Completion MAR 23 1955Remarks Hamilton PoolBaker - Contr.Spudding Date 1-10-55Drlg. Data Oil well TD 17828" @ 673 7" @ 1296 Miss. 1780TD 1782 5" @ 1708 CO to 1782500 A P/ 150 bo 12 hr.Comp. 20 bopd

FABEN GILSTRAP