


Map No. _____ Sec. 11 Twp. 28 R. 4

Well No. 2 - Shreeves Farm
G.M. Smith et al Company

NORTH

WEST

EAST

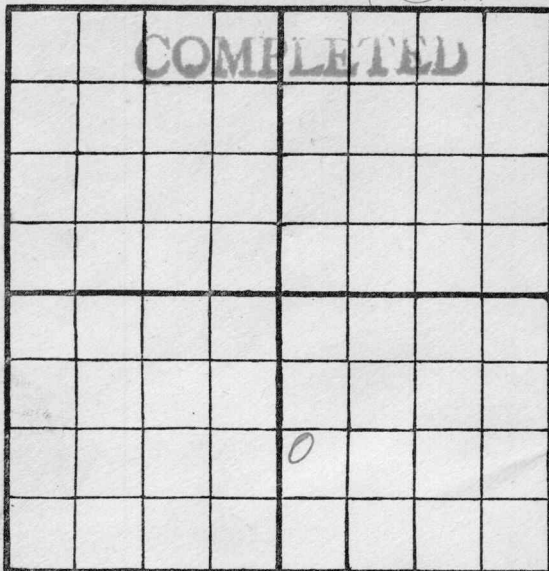

SOUTH

Location _____

Rig Up _____

Drilling Remarks:

Drilling Remarks:

RECORD

Cased _____ in. _____ ft.

Sand _____

Gas _____

Oil _____

Total Depth _____

PRODUCTION

1st 24 hrs. Nat. _____

1st 24 hrs. after shot _____

Gas _____ cu. ft

Dry Hole _____


Abandoned _____

1002 K 118
 Map No. _____ Sec. 14 Twp. 28 R. 4
 Well No. 2 Shreeves
 H. M. Smith & Co. Company
 Contractor

NORTH

WEST

EAST

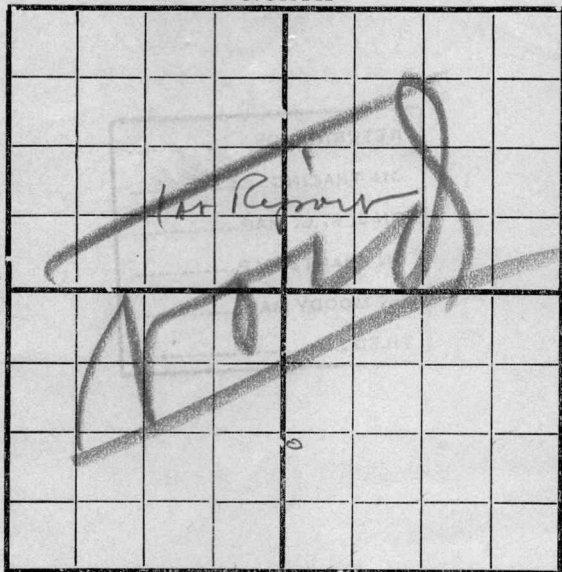

SOUTH

Location _____

Rig up _____

Drilling and Remarks:

In wrong
 section -
 should be
 sec. 11-28-4

RECORD

Cased _____ in., _____ ft.

Sand _____

Gas _____

Oil _____

Total Depth _____

PRODUCTION

1st 24 hrs. Nat. _____

1st 24 hrs. after shot _____

Gas _____ Cu. Ft.

Dry Hole _____

Abandoned _____

Date

9/5 1917 Cardiff Scout

Map No. _____ Sec. 11 Twp. 28 R. 4


Well No. 2 Shreener Farm _____

B M Smith et al Company

NORTH

WEST

EAST

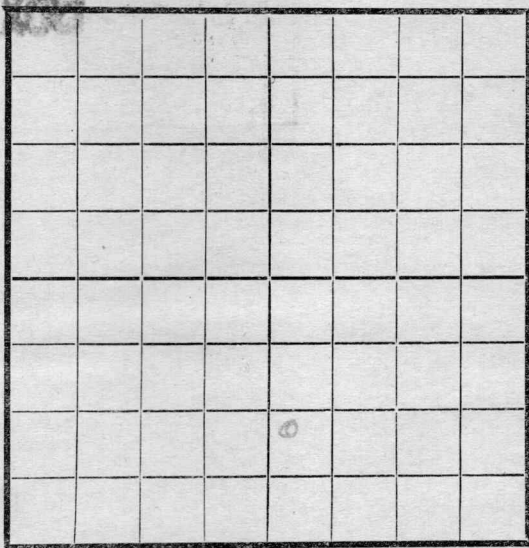

SOUTH

Location _____

Rig Up _____

Drilling and remarks

2250

RECORD

Cased _____ in. _____ Ft.

Sand _____

Gas _____

Oil _____

Total Depth _____

PRODUCTION

1st 24 hrs. Nat. _____

1st 24 hrs. after shot _____

Gas _____ Cu. Ft.

Dry Hole _____

Abandoned _____


Date

10/9, 1917 C. C. C. Scout

Map No. _____ Sec. 11 Twp. 28 R. 4Well No. 2 Shreeves Farm
G M Smith et al Company

NORTH

WEST

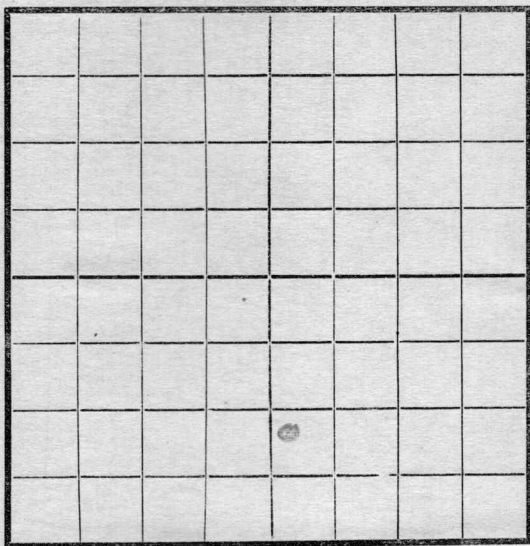

EAST

SOUTH

Location _____

Rig Up _____

Drilling and remarks

8405

RECORD

Cased _____ in. _____ Ft.

Sand _____

Gas _____

Oil _____

Total Depth _____

PRODUCTION

1st 24 hrs. Nat. _____

1st 24 hrs. after shot _____

Gas _____ Cu. Ft.

Dry Hole _____

Abandoned _____


Date

10/17, 1917 Endy Scout

Map No. _____ Sec. 11 Twp. 28 R. 4Well No. 2 Shreeve Farm
Edna Smith et al Company

NORTH

WEST

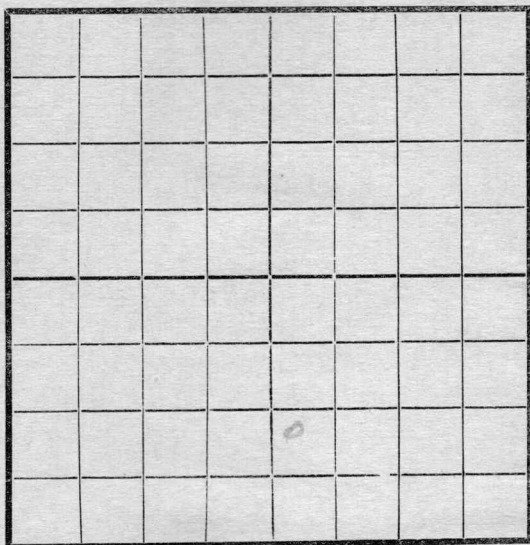

EAST

SOUTH

Location _____

Rig Up _____

Drilling and remarks

22 on
Top sand
2650

RECORD

Cased _____ in. _____ Ft.

Sand _____

Gas _____

Oil _____

Total Depth _____

PRODUCTION

1st 24 hrs. Nat. _____

1st 24 hrs. after shot _____

Gas _____ Cu. Ft.

Dry Hole _____

Abandoned _____


Date

10/24, 1917 Carlyle Scout

Map No. _____ Sec. 11 Twp. 38 R. 4Well No. 2 Shreeves Farm _____
Smith et al Company

NORTH

WEST

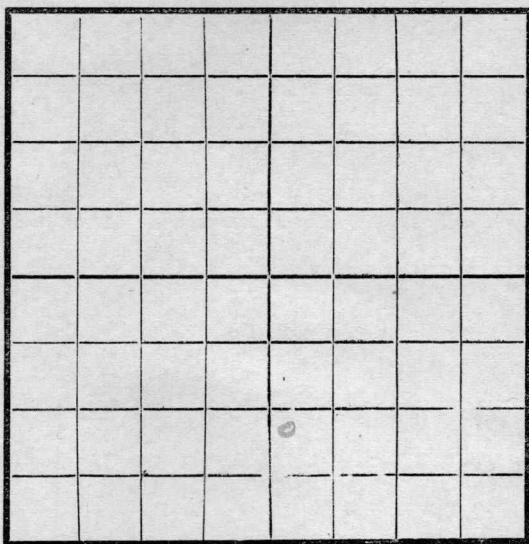

EAST

SOUTH

Location _____

Rig Up _____

Drilling and remarks

T.S. 2650Shut down

RECORD

Cased _____ in. _____ Ft.

Sand _____

Gas _____

Oil _____

Total Depth _____

PRODUCTION

1st 24 hrs. Nat. _____

1st 24 hrs. after shot _____

Gas _____ Cu. Ft.

Dry Hole _____

Abandoned _____

Date


10/31, 1917 C. Smith Scout

Map No. _____ Sec. 11 Twp. 28 R. 4

Well No. 2 Shreeves Farm
G M Smith et al Company

NORTH

WEST

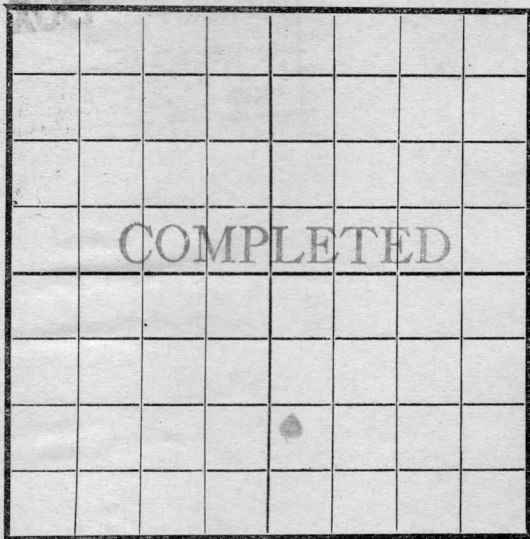

EAST

SOUTH

Location _____

Rig Up _____

Drilling and remarks

Est at
70

Barrels

RECORD

Cased _____ in. _____ Ft.

Sand 2650-2662

Gas _____

Oil _____

Total Depth _____

PRODUCTION

1st 24 hrs. Nat. _____

1st 24 hrs. after shot _____

Gas _____ Cu. Ft.

Dry Hole _____

Abandoned _____

Date

11-7, 1917 Candiff Scout