

A 10x10 grid with a watermark reading 'COMPLETED' diagonally across the center. The word 'WEST' is written vertically on the left side, 'EAST' on the right side, and 'SOUTH' at the bottom center. A small, dark, oval-shaped mark is present in the lower-right quadrant of the grid.

Location -----

Drilling Remarks:

RECORD

Cased_____ in._____ ft.

Sand _____

Gas -----

Oil -----

Total Depth-----

Rig Up -----

Drilling Remarks:

PRODUCTION

1st 24 hrs. Nat.-----

1st 24 hrs. after shot-----

Gas----- cu. ft.

Dry Hole -----


Abandoned -----

Map No. 100 V H 11 Sec. 11 Twp. 28 R. 4

Well No. 3 Shreeves Farm
Atlas Dr Company

NORTH

WEST

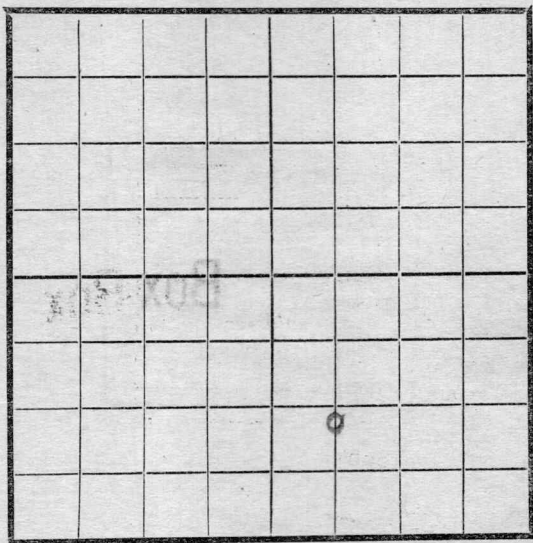

EAST

SOUTH

Location ✓Rig Up ✓

Drilling and remarks

RECORD

Cased _____ in. _____ Ft.

Sand _____

Gas _____

Oil _____

Total Depth _____

First Report

PRODUCTION

1st 24 hrs. Nat. _____

1st 24 hrs. after shot _____

Gas _____ Cu. Ft.

Dry Hole _____

Abandoned _____

Date

3/22, 1918 Conroy Scout

Map No. 111 Sec. 11 Twp. 28 R. 4

Well No. 3 Shreeves Farm

Atlas Dr Company

NORTH

SOUTH

Location ✓

Rig up ✓

Drilling and remarks:

RECORD

Cased in. Ft.

Sand

Gas

Oil

Total Depth

PRODUCTION

1st 24 hrs. Nat.

1st 24 hrs. after shot

Gas Cu. Ft.

Dry Hole

Abandoned

FIRST REPORT


Date

4/3, 1911, S. Condy Scout

Map No. _____ Sec. 11 Twp. 28 R. 4Well No. 3 Shreene Farm _____
Atlas Dev Company _____

NORTH

WEST

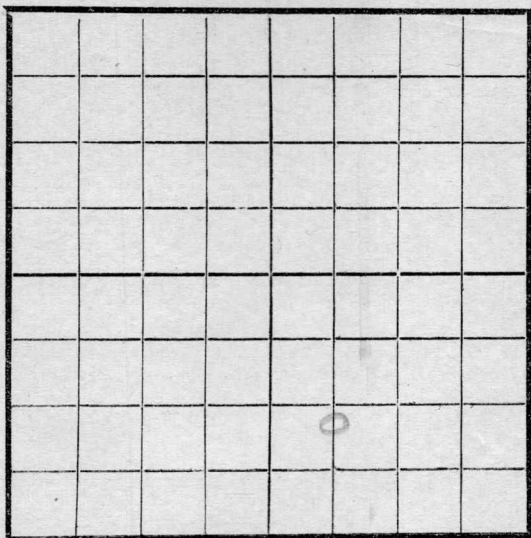

EAST

SOUTH

RECORD

Location _____

Cased _____ in. _____ Ft

Rig Up _____

Sand _____

Drilling and remarks

Gas _____

Oil _____

Total Depth _____

PRODUCTION

1st 24 hrs. Nat. _____

1st 24 hrs. after shot _____

Gas _____ Cu. Ft.

Dry Hole _____

Abandoned _____

Date

4/17, 1918 S Cardy Scout


Map No. 1002 R 11 Sec. 11 Twp. 28 R. 4

Well No. 3 Success Farm

Minnesota - Kansas Company

NORTH

WEST

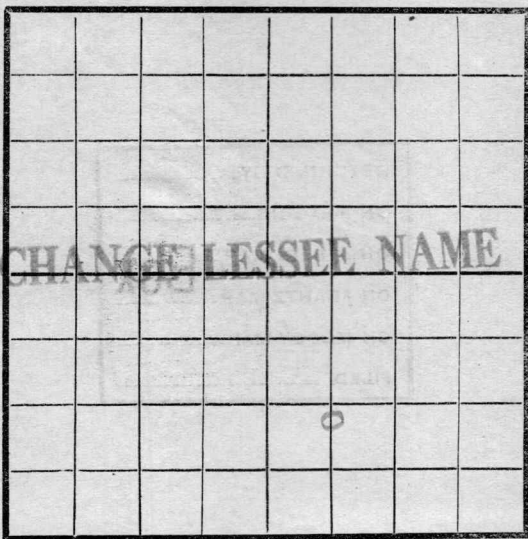

EAST

SOUTH

Location -----

Rig Up -----

Drilling and remarks

1022

RECORD

Cased ----- in. ----- Ft.

Sand -----

Gas -----

Oil -----

Total Depth -----

PRODUCTION

1st 24 hrs. Nat. -----

1st 24 hrs. after shot -----

Gas ----- Cu. Ft.

Dry Hole -----

Abandoned -----

Date


4/24, 1911 S Conley Scout

Map No. _____ Sec. 11 Twp. 28 R. 4

Well No. 3 Shreiner Farm _____
Minnesota - Kansas Company

NORTH

WEST

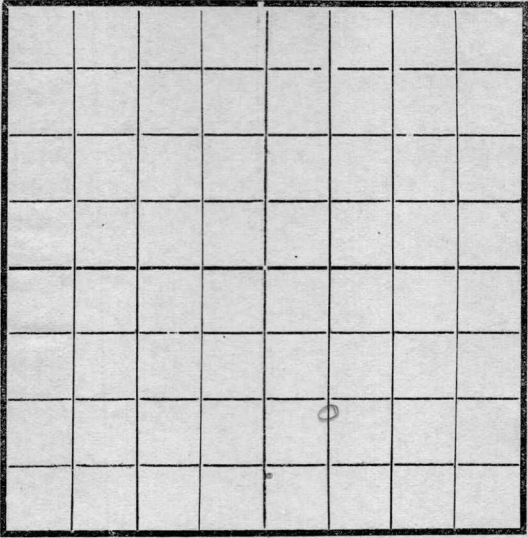

EAST

SOUTH


RECORD		
Location _____	Cased _____ in. _____ Ft.	
Rig Up _____	Sand _____	
Drilling and remarks	Gas _____	
<u>22 1200</u>	Oil _____	
	Total Depth _____	
	PRODUCTION	
	1st 24 hrs. Nat. _____	
	1st 24 hrs. after shot _____	
	Gas _____ Cu. Ft.	
	Dry Hole _____	
	Abandoned _____	

Date 5/1, 1911 P. Carliff Scout

Map No. _____ Sec. 11 Twp. 28 R. 4
Well No. 3 Shireen Farm _____
Minnicoukhan Company

NORTH

WEST

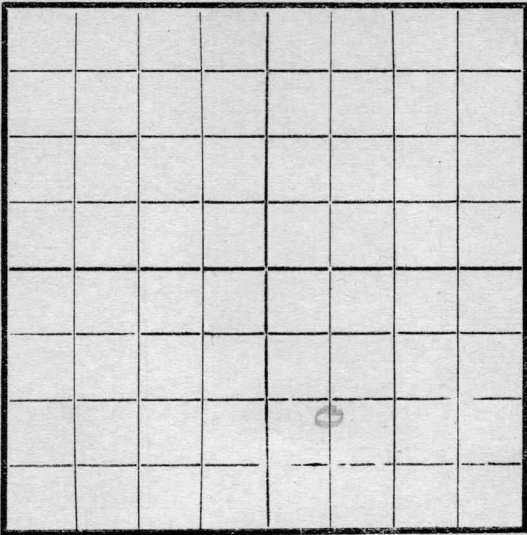

EAST

SOUTH


RECORD	
Location _____	Cased _____ in. _____ Ft.
Rig Up _____	Sand _____
Drilling and remarks	Gas _____
	Oil _____
	Total Depth _____
	PRODUCTION
	1st 24 hrs. Nat. _____
	1st 24 hrs. after shot _____
	Gas _____ Cu. Ft.
	Dry Hole _____
	Abandoned _____

Date 578, 1918 Scout

Map No. _____ Sec. 11 Twp. 28 R. 4Well No. 3 Shivers FarmMinnesota-Kan Company

NORTH

WEST

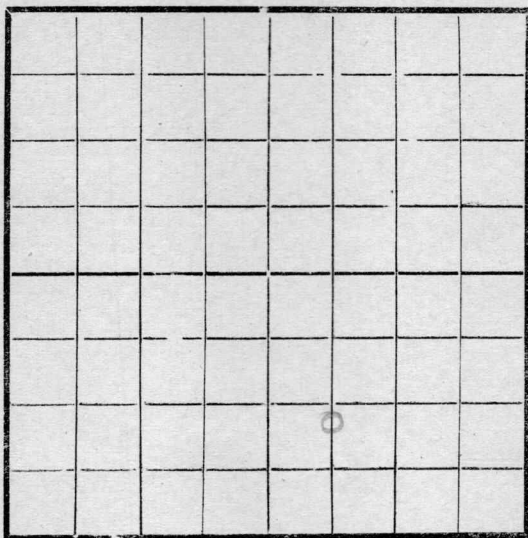

EAST

SOUTH

Location _____

Rig Up _____

Drilling and remarks

1480

RECORD

Cased _____ in. _____ Ft.

Sand _____

Gas _____

Oil _____

Total Depth _____

PRODUCTION

1st 24 hrs. Nat. _____

1st 24 hrs. after shot _____

Gas _____ Cu. Ft.

Dry Hole _____

Abandoned _____


Date

5/15, 1918J. C. Condy Scout

Map No. _____ Sec. 11 Twp. 28 R. 4Well No. 3 Shreve Farm _____Minneapolis-Kansas Company

NORTH

WEST

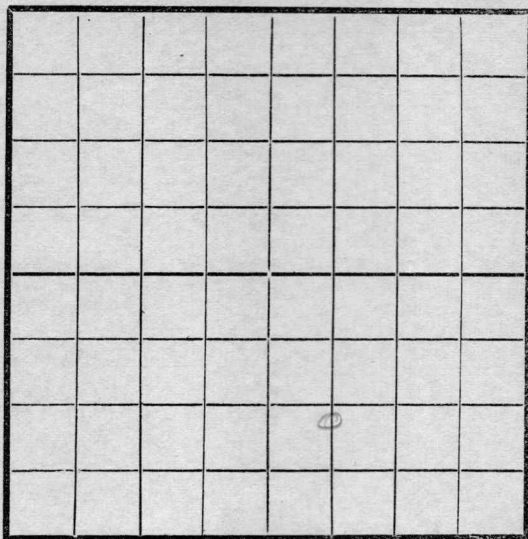

EAST

SOUTH

Location _____

Rig Up _____

Drilling and remarks

RECORD

Cased _____ in. _____ Ft.

Sand _____

Gas _____

Oil _____

Total Depth _____

PRODUCTION

1st 24 hrs. Nat. _____

1st 24 hrs. after shot _____

Gas _____ Cu. Ft.

Dry Hole _____

Abandoned _____

Date

5/22, 1918 Candiff Scout

Map No. _____ Sec. 11 Twp. 28 R. 4


Well No. 3 Shreener Farm

Minnesota & Kansas Company

NORTH

WEST

EAST

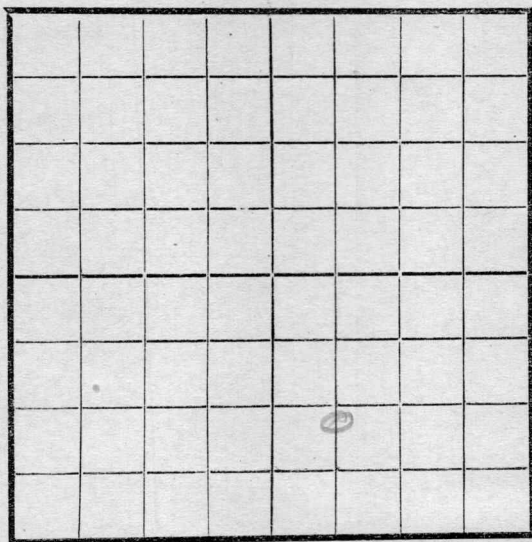

SOUTH

Location _____

Rig Up _____

Drilling and remarks

Fishing
Casing
1480

RECORD

Cased _____ in. _____ Ft

Sand _____

Gas _____

Oil _____

Total Depth _____

PRODUCTION

1st 24 hrs. Nat. _____

1st 24 hrs. after shot _____

Gas _____ Cu. Ft.

Dry Hole _____

Abandoned _____

Date

5/29/8 *Candy* _____ Sc

Map No. _____ Sec. 11 Twp. 28 R. 4

Well No. 3 Shrover

Munroe & Co. Company

Contractor

NORTH

WEST

EAST

SOUTH

Location _____

Rig up _____

Drilling and Remarks:

SD
1480.

RECORD

Cased _____ in., _____ ft.

Sand _____

Gas _____

Oil _____

Total Depth _____

PRODUCTION

1st 24 hrs. Nat. _____

1st 24 hrs. after shot _____

Gas _____ Cu. Ft.

Dry Hole _____

Abandoned _____

Date

6/5 191 S. Condy Scout

Map No. _____ Sec. 11 Twp. 28 R. 4Well No. 3 ShreeneMineco to know Company

Contractor _____

NORTH

WEST

EAST

SOUTH

Location _____

Rig up _____

Drilling and Remarks:

Casing
Trouble
1480

RECORD

Cased _____ in., _____ ft.

Sand _____

Gas _____

Oil _____

Total Depth _____

PRODUCTION

1st 24 hrs. Nat. _____

1st 24 hrs. after shot _____

Gas _____ Cu. Ft.

Dry Hole _____

Abandoned _____

Date

6/13 191 J. Condy Scout

Scout

Map No. _____ Sec. 11 Twp. 28 R. 4Well No. 3 ShreevesMinnesota-Kansas Company_____
Contractor

NORTH

WEST

EAST

SOUTH

Location _____

Rig up _____

Drilling and Remarks:

*Shut down
1480*

RECORD

Cased _____ in., _____ ft.

Sand _____

Gas _____

Oil _____

Total Depth _____

PRODUCTION

1st 24 hrs. Nat. _____

1st 24 hrs. after shot _____

Gas _____ Cu. Ft.


Dry Hole _____

Abandoned _____

Date

6/26 1918 P. Condy Scout

Map No. _____ Sec. 11 Twp. 28 R. 4
Well No. 3 Shreeves
Shreeves Company
Contractor _____

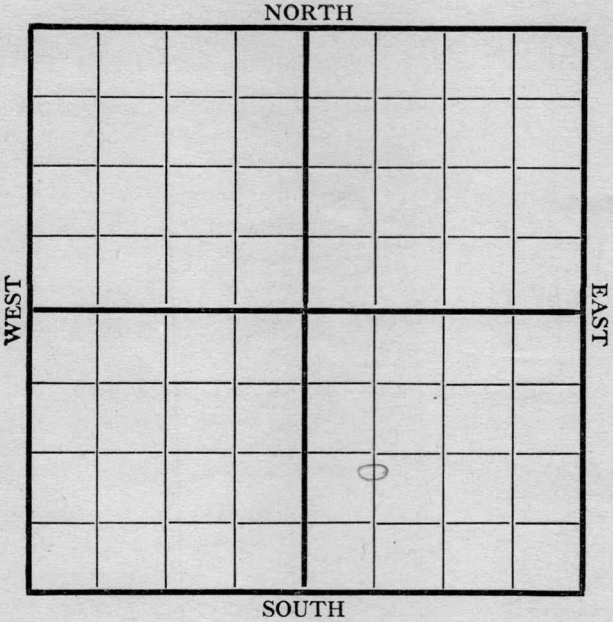

Location _____
Rig up _____
Drilling and Remarks:

Bad hole
1480
Shut Down

RECORD


Cased _____ in., _____ ft.
Sand _____
Gas _____
Oil _____
Total Depth _____

PRODUCTION

1st 24 hrs. Nat. _____
1st 24 hrs. after shot _____
Gas _____ Cu. Ft.
Dry Hole _____
Abandoned _____

Date 7/3 191 8 Cordry Scout

Map No. _____ Sec. 11 Twp. 28 R. 4
 Well No. 3 Shreeves
Minnesota-Kans. Company
 Contractor _____

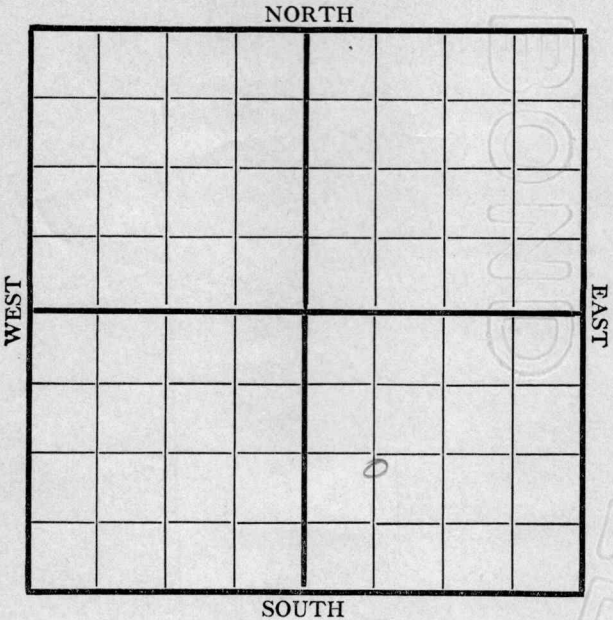

	RECORD
Location _____	Cased _____ in., _____ ft.
Rig up _____	Sand _____
Drilling and Remarks:	Gas _____
SD 1480	Oil _____
	Total Depth _____
	PRODUCTION
	1st 24 hrs. Nat. _____
	1st 24 hrs. after shot _____
	Gas _____ Cu. Ft.
	Dry Hole _____
	Abandoned _____

Date 7/10 191 J. C. Condy Scout

100-111
Map No. 11 Sec. 11 Twp. 28 4 R. 4

Well No. 3 Shreeves


Minnesota - Kansas Company

Contractor

NORTH

WEST

EAST

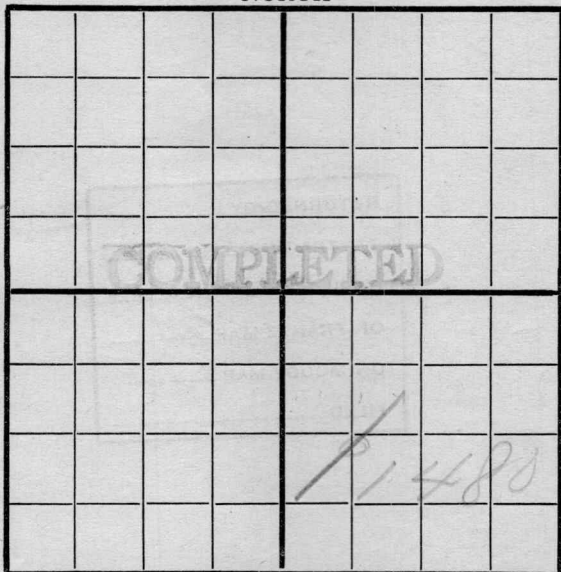

SOUTH

Location

Rig up

Drilling and Remarks:

Abandoned
1480'

RECORD

Cased _____ in., _____ ft.

Sand _____

Gas _____

Oil _____

Total Depth _____

PRODUCTION

1st 24 hrs. Nat. _____

1st 24 hrs. after shot _____

Gas _____ Cu. Ft.

Dry Hole _____

Abandoned _____

Date

7/17 191 8 Caudy

Scout