

Map No. _____ Sec. 11 Twp. 28 R. 4


Well No. 4 S Shreeves Farm

Minnesota - Kansas Company

NORTH

WEST

EAST

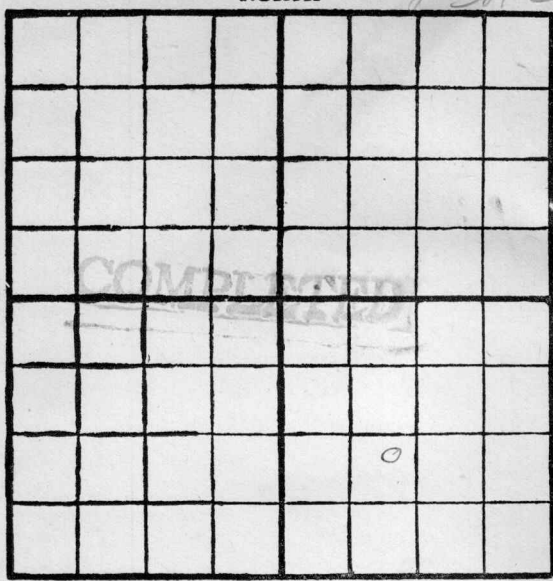

SOUTH

Location _____

Rig Up _____

Drilling Remarks:

Drilling Remarks:

RECORD

PRODUCTION

Cased _____ in. _____ ft.

1st 24 hrs. Nat. _____

Sand _____

1st 24 hrs. after shot _____

Gas _____

Gas _____ cu. ft.

Oil _____

Dry Hole _____

Total Depth _____

Abandoned _____

Map No. _____ Sec. 11 Twp. 28 R. 4

Well No. 4 Shreevea Farm

Minn Kans Oil Co. Company


 _____ Contractor 86. Quarter

 _____ Ft. from N. Line

1120 _____ Ft. from S. Line

 _____ Ft. from E. Line

1120 _____ Ft. from W. Line

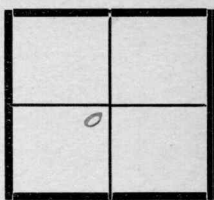


Date

REPORT

1919
10/11 Rig
11/10 Shut down 1300'
12/11 to 1300'
20 Dry abandoned at 790'

COMPLETED

Map No. K11 Sec. 11 Twp. 28 R. 4
 Well No. 4 Shreves
Minnesota-Texas Company
 Contractor

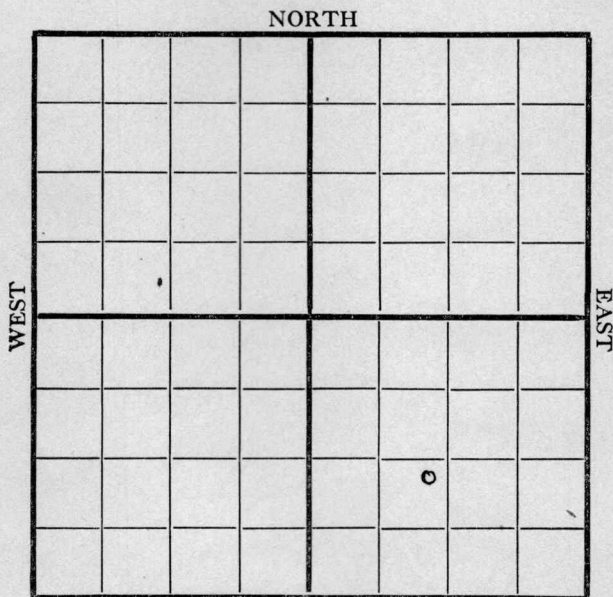

1120S-W

Location _____

Rig up. ☒

Drilling and Remarks:

RECORD

Cased _____ in., _____ ft.

Sand _____

Gas _____

Oil _____

Total Depth _____

PRODUCTION

1st 24 hrs. Nat. _____

1st 24 hrs. after shot _____

Gas _____ Cu. Ft.

Dry Hole _____

Abandoned _____

Date

11/4

191

8

Scout


Map No. 111 Sec. 11 Twp. 28 R. 4Well No. 4 3 ShreevesMinnesota - Okech Company

Contractor

NORTH

WEST

EAST

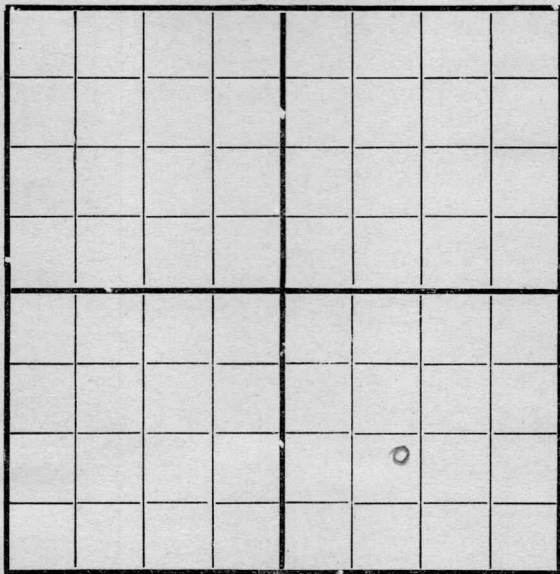1120 S-W SOUTH

Location _____

Rig up ☒

Drilling and Remarks:

RECORD

Cased _____ in., _____ ft.

Sand _____

Gas _____

Oil _____

Total Depth _____

PRODUCTION

1st 24 hrs. Nat. _____

1st 24 hrs. after shot _____

Gas _____ Cu. Ft.

Dry Hole _____

Abandoned _____

Date

11/13 191 8 Cand Scout


Map No. K 11 Sec. 11 Twp. 28 R. 4Well No. 4 ShreeverMinnesota - OKly Company

Contractor

NORTH

WEST

EAST

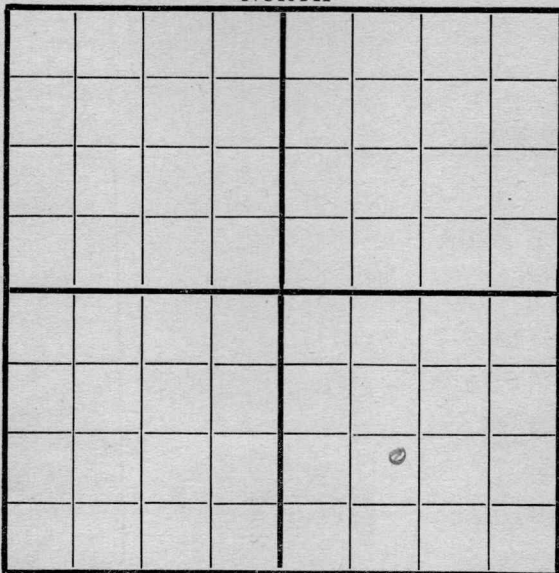

SOUTH

Location _____

Rig up ☒ _____

Drilling and Remarks:

RECORD

Cased _____ in., _____ ft.

Sand _____

Gas _____

Oil _____

Total Depth _____

PRODUCTION

1st 24 hrs. Nat. _____

1st 24 hrs. after shot _____

Gas _____ Cu. Ft.

Dry Hole _____

Abandoned _____

Date

11/20 1918 J. Conley Scout


Map No. K11 Sec. 11 Twp. 28 R. 4Well No. 4 ShrevesMinnesota-Oklahoma Company

Contractor

NORTH

WEST

EAST

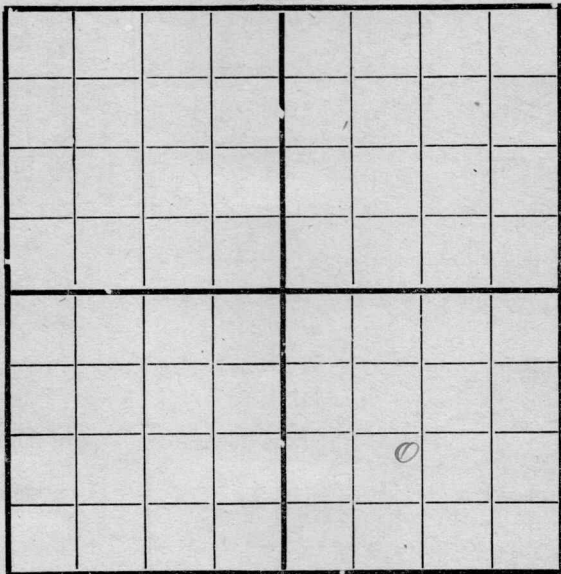

SOUTH

112084 W

Location _____

Rig up ☒ _____

Drilling and Remarks:

RECORD

Cased _____ in., _____ ft.

Sand _____

Gas _____

Oil _____

Total Depth _____

PRODUCTION

1st 24 hrs. Nat. _____

1st 24 hrs. after shot _____

Gas _____ Cu. Ft.

Dry Hole _____

Abandoned _____

Date

11/29 191 S. Condy Scout


Map No. 1511 Sec. 11 Twp. 28 R. 4Well No. 4 Shreve
Minnesota Okla Company

Contractor

NORTH

WEST

EAST

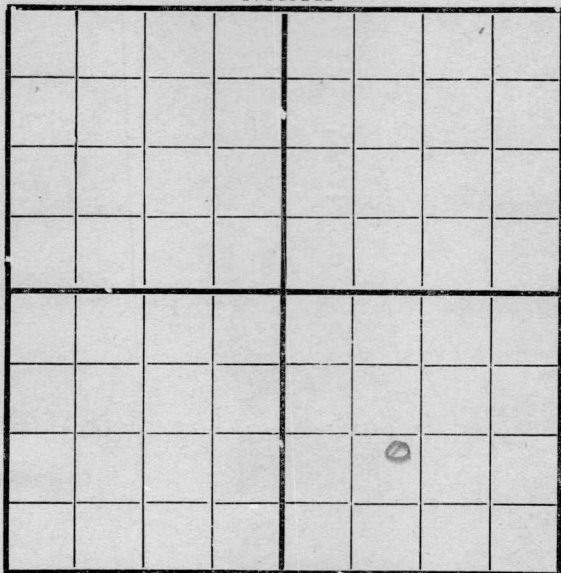

SOUTH

Location _____

Rig up ☒

Drilling and Remarks:

RECORD

Cased _____ in., _____ ft.

Sand _____

Gas _____

Oil _____

Total Depth _____

PRODUCTION

1st 24 hrs. Nat. _____

1st 24 hrs. after shot _____

Gas _____ Cu. Ft.

Dry Hole _____

Abandoned _____

Date

12/4 191 8 Conley Scout

Map No. K 11 Sec. 11 Twp. 28 R. 4Well No. 4 ShreevesMinnesota - OPL Company

Contractor

NORTH

WEST

EAST

SOUTH

Location _____

Rig up ☒

Drilling and Remarks:

RECORD

Cased _____ in., _____ ft.

Sand _____

Gas _____

Oil _____

Total Depth _____

PRODUCTION

1st 24 hrs. Nat. _____

1st 24 hrs. after shot _____

Gas _____ Cu. Ft.

Dry Hole _____

Abandoned _____

Date

12/11 191 8 Coney Scout

Map No. 511 Sec. 11 Twp. 28 R. 4Well No. 4 ShreveMinnesota-Oke Company

Contractor

NORTH

WEST

EAST

SOUTH

Location _____

Rig up ☒

Drilling and Remarks:

RECORD

Cased _____ in., _____ ft.

Sand _____

Gas _____

Oil _____

Total Depth _____

PRODUCTION

1st 24 hrs. Nat. _____

1st 24 hrs. after shot _____

Gas _____ Cu. Ft.

Dry Hole _____

Abandoned _____

Date

191

Scout


Map No. 154 Sec. 11 Twp. 28 R. 4Well No. 4 ShrevesMinnesota Company

Contractor

NORTH

WEST

EAST

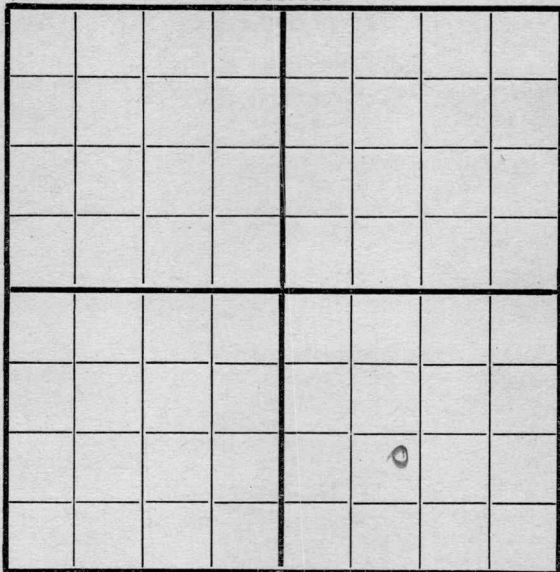

SOUTH

RECORD

Location _____

Cased _____ in., _____ ft.

Rig up ☒ _____

Sand _____

Drilling and Remarks:

Gas _____

Oil _____

Total Depth _____

PRODUCTION

1st 24 hrs. Nat. _____

1st 24 hrs. after shot _____

Gas _____ Cu. Ft.

Dry Hole _____

Abandoned _____

Date

10/25/8

Scout


Map No. 8 11 Sec. 11 Twp. 28 R. 4Well No. 4 ShreevesMinnesota-Kansas Company

Contractor _____

NORTH

WEST

EAST

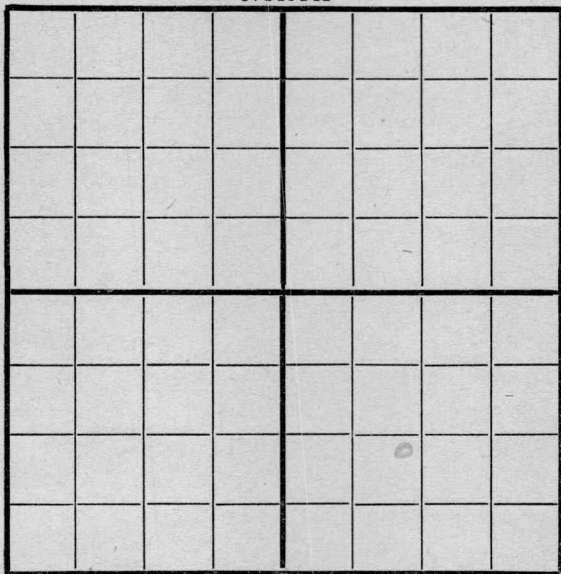

SOUTH

RECORD

Location _____

Cased _____ in., _____ ft.

Rig up ☒ _____

Sand _____

Drilling and Remarks:

Gas _____

Oil _____

Total Depth _____

PRODUCTION

1st 24 hrs. Nat. _____

1st 24 hrs. after shot _____

Gas _____ Cu. Ft.

Dry Hole _____

Abandoned _____

Date

191 9Scout Condy


Map No. K 11 Sec. 11 Twp. 28 R. 4Well No. 4 ShreeneMinnesota Kansas Company

Contractor

NORTH

WEST

EAST

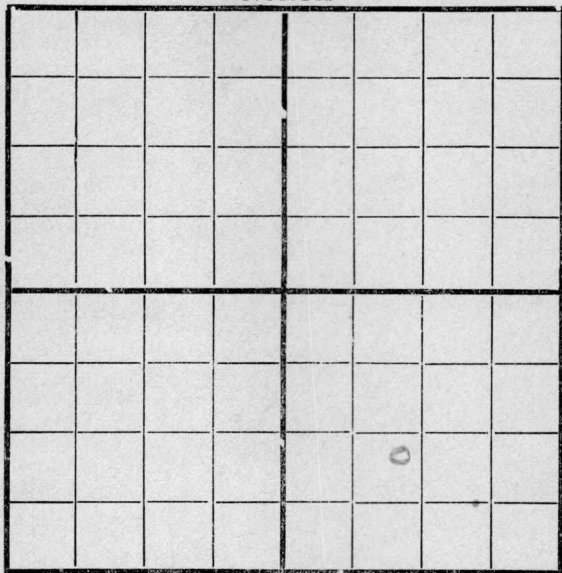

SOUTH

Location 1120 84 W.Rig up ☒

Drilling and Remarks:

RECORD

Cased _____ in., _____ ft.

Sand _____

Gas _____

Oil _____

Total Depth _____

PRODUCTION

1st 24 hrs. Nat. _____

1st 24 hrs. after shot _____

Gas _____ Cu. Ft.

Dry Hole _____

Abandoned _____

Date

1/8

191

G. Conroy

Scout


Map No. 1511 Sec. 11 Twp. 28 R. 4Well No. 4 ShreevesMinnesota Company

Contractor

NORTH

WEST

EAST

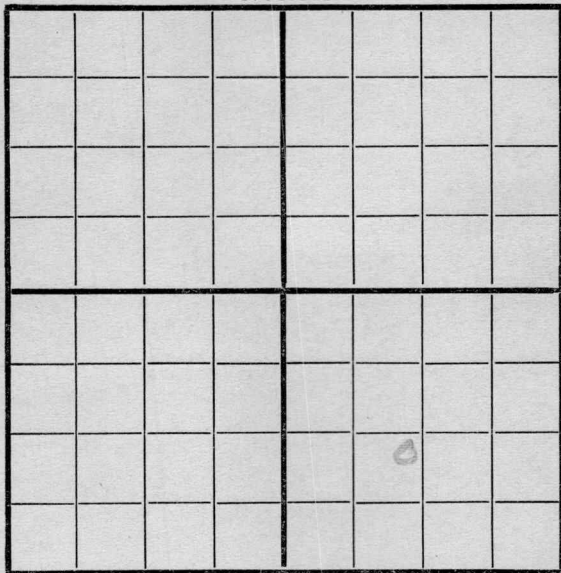

SOUTH

RECORD

Location _____

Cased _____ in., _____ ft.

Rig up ☒ _____

Sand _____

Drilling and Remarks:

Gas _____

Oil _____

Total Depth _____

PRODUCTION

1st 24 hrs. Nat. _____

1st 24 hrs. after shot _____

Gas _____ Cu. Ft.

Dry Hole _____

Abandoned _____

Date

1/15 191 9 Conroy Scout


Map No. K 11 Sec. 11 Twp. 28 R. 4Well No. 4 SchreinerMinnesota Trans Company

Contractor

NORTH

WEST

EAST

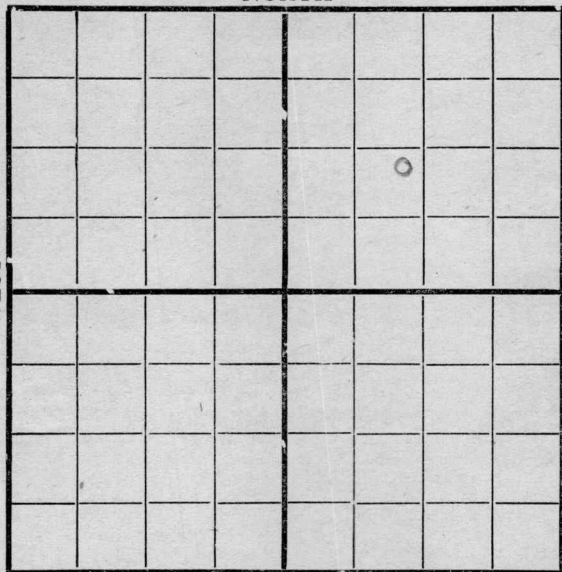

SOUTH

1120 S & W

Location _____

Rig up ☒

Drilling and Remarks:

RECORD

Cased _____ in., _____ ft.

Sand _____

Gas _____

Oil _____

Total Depth _____

PRODUCTION

1st 24 hrs. Nat. _____

1st 24 hrs. after shot _____

Gas _____ Cu. Ft.

Dry Hole _____

Abandoned _____

Date

1/22 1919 Conley Scout


Map No. K 11 Sec. 11 Twp. 28 R. 4Well No. 4 ShreevesMinnesota Kansas Company

Contractor

NORTH

WEST

EAST

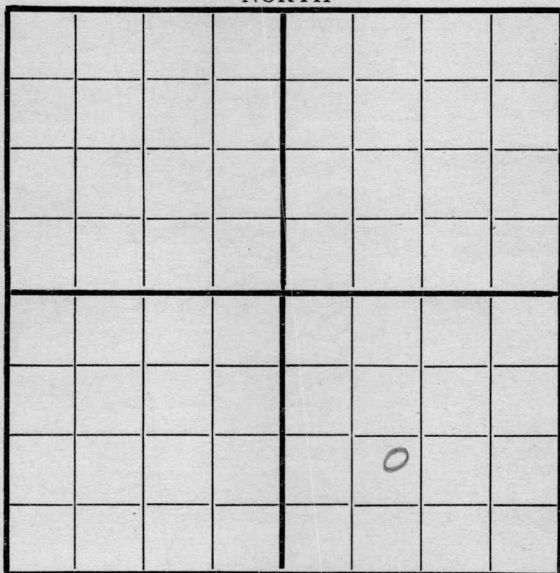

SOUTH

11205-VV

Location _____

Rig up ☒ _____

Drilling and Remarks:

RECORD

Cased _____ in., _____ ft.

Sand _____

Gas _____

Oil _____

Total Depth _____

PRODUCTION

1st 24 hrs. Nat. _____

1st 24 hrs. after shot _____

Gas _____ Cu. Ft.

Dry Hole _____

Abandoned _____

Date

3/81919

Pyle

Scout

Map No. K11 Sec. 11 Twp. 28 R. 4

Well No. 4 Shreeves
Minnesota - Kansas Company

Minnesota - Kansas Company

Contractor

NORTH

WEST

EAST

SOUTH

1120 S. W.

Location _____

Rig up.....

Drilling and Remarks:

1300'

RECORD

Cased _____ in., _____ ft.:

Sand_____

Gas -----

Oil _____

Total Depth_____

PRODUCTION

1st 24 hrs. Nat. -----

1st 24 hrs. after shot-----

Gas _____ Cu. Ft.

Dry Hole.....

Abandoned.....

Date _____

7/21

191 9

Pyke

Scout

Map No. K 11 Sec. 11 Twp. 28 R. 4Well No. 4 ShreevesMinnesota - Kansas Company


Contractor

SECTION PLAT

Ft. from N. Line

1120 Ft. from S. Line

Ft. from E. Line

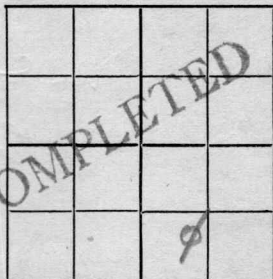1120 Ft. from W. Line

RECORD

Location -----

Cased ----- in., ----- ft.

Rig up -----

Sand -----

Drilling and Remarks:

Gas -----

Oil -----

Total Depth -----

PRODUCTION

1st 24 hrs. Nat. -----

1st 24 hrs. after shot -----

Gas ----- Cu. Ft.

Dry Hole 2790 -----

Abandoned -----

Date

12/20 1919

Pyle

Scout