

Section 11 Township 28 Range 4E

Well No. #1 Wallace

Company Martin & Cash

NORTH

	0						

WEST

EAST

SOUTH



Sec. 11 Twp. 28 R. 4-E

Well No. #1 Wallace Farm

Martin & Cash Company

Contractor


Miscellaneous

990 Ft. from N. Line

_____ Ft. from S. Line

_____ Ft. from E. Line

990 Ft. from W. Line

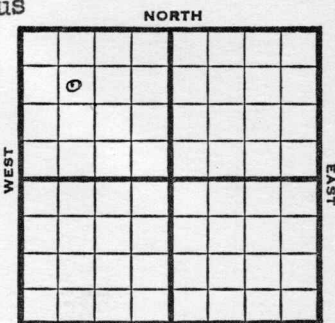

SE NW NW

Cities Service Farm ~~out~~

1950 Elev 1307 REPORT

3/22 RUR

5/17 TD 2085
8" @90
KC 2081-85
5 1/2" @ 2085
15 BOPD
Completed

COMPLETED

Map No. _____ Sec. 11 Twp. 28 R. 4E

Well No. 1 Wallace

Martin & Cash Company

Contractor

SE NW NW

SECTION PLAT

990 Ft. from N. Line

_____ Ft. from S. Line

_____ Ft. from E. Line

990 Ft. from W. Line



Butler County

Cities Service farmout

Location _____

Rig up _____

Drilling and Remarks:

R U R

RECORD

Cased _____ in., _____ ft.

Sand _____

Gas _____

Oil _____

Total Depth _____

PRODUCTION

1st 24 hrs. Nat. _____

1st 24 hrs. after shot _____

Gas _____ Cu. Ft.

Dry Hole _____

Abandoned _____

Date

MAR 22 1950 19 _____

J. E. TYRA

Scout

Kansas

Miscellaneous

Map No. _____ Sec. 11 Twp. 28 R. 4E

Well No. 1 Wallace

Martin & Cash Company

Contractor

SE NW NW

El. 1307
SECTION PLAT

990 Ft. from N. Line

_____ Ft. from S. Line

_____ Ft. from E. Line

990 Ft. from W. Line

0			

COMPLETE

Butler

Location _____

Rig up _____

Drilling and Remarks:

8' @ 90
AC 2081-85
5 1/2" @ 2085
15 BOPD

RECORD

Cased _____ in., _____ ft.

Sand _____

Gas _____

Oil _____

Total Depth 2085

PRODUCTION

1st 24 hrs. Nat. _____

1st 24 hrs. after shot _____

Gas _____ Cu. Ft.

Dry Hole _____

Abandoned _____

Date

MAY 17 1950

19

J. E. TYRA

Scout