


Section 8 Township 24 Range 12EWell No. #4 JohnsonCompany Associated Recourse Co.

NORTH

WEST

EAST

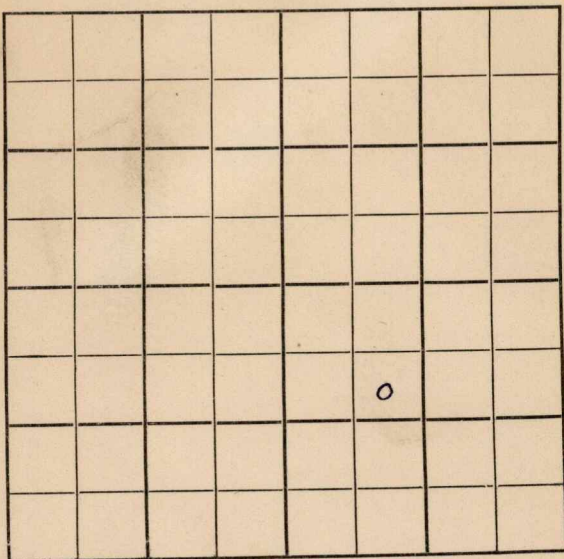

SOUTH

Greenwood

KANSAS

Sec. 8 Twp. 24 R. 12E

Well No. #4 Johnson Farm

Associated Recourse Co. Company

Berentsz Drlg. - Contr. Contractor

Hamilton Pool


990' Ft. from N. Line

Ft. from S. Line

Ft. from E. Line

990' Ft. from W. Line

SE NW SE

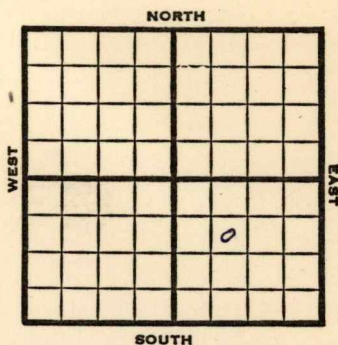

1951

Elev. -

REPORT

8/15 Spud 8-11-51
10" @ 60'
Drlg. 980'

9/19 Spud 8-11-51
Oil Well TD 1698
10" @ 60'
Bart 1673-88
5" @ 1674
TD 1698
FU 500' oil
60/qt 1673-88
Comp. 40 bopd

COMPLETED

County Greenwood State Kansas
 Sec. 8 (Blk.) 24 (Sur.) 12E Map No.
 Operator Associated Recourse Co.
 Well No. 4 Farm Johnson
 Elev. Location SE NW SE

FIRST REPORT

990 Ft. From N Line SE
990 Ft. From W Line Quarter

1st. Report AUG 15 1951

Completion

Remarks

Berentz Drlg. - Contr.

Spudding Date 8-11-51

Drlg. Data Hamilton Pool

10" @ 60 drlg. 980

J. E. TYRA

