

Map No. _____ Sec. 12 Twp. 28 R. 4

Well No. 1 Wallace Farm
National Ref. Company

National Res.

Company

NORTH



EAST

SOUTH

Location -----

Drilling Remarks:

Rig Up -----

Drilling Remarks:

RECORD

Cased-----in. -----ft.

Sand -----

Gas -----

Oil_____

Total Depth -----

PRODUCTION

1st 24 hrs. Nat.-----

1st 24 hrs. after shot-----

Gas-----cu. ft.

Dry Hole -----

Abandoned -----

Map No. K 11 Sec. 12 Twp. 28 R. 4
 Well No. 1 Hallace
National Ref Company
 Contractor

NORTH

SOUTH

WEST

EAST

FIRST REPORT

240 N-E

SOUTH

Location _____

Rig up ☒

Drilling and Remarks:

RECORD

Cased _____ in., _____ ft.

Sand _____

Gas _____

Oil _____

Total Depth _____

PRODUCTION

1st 24 hrs. Nat. _____

1st 24 hrs. after shot _____

Gas _____ Cu. Ft.

Dry Hole _____

Abandoned _____

Date

7/18

1919

Pyle

Scout


Map No. K 11 Sec. 12 Twp. 28 R. 4Well No. 1 Wallace
National Ref. Company

Contractor

NORTH

WEST

EAST

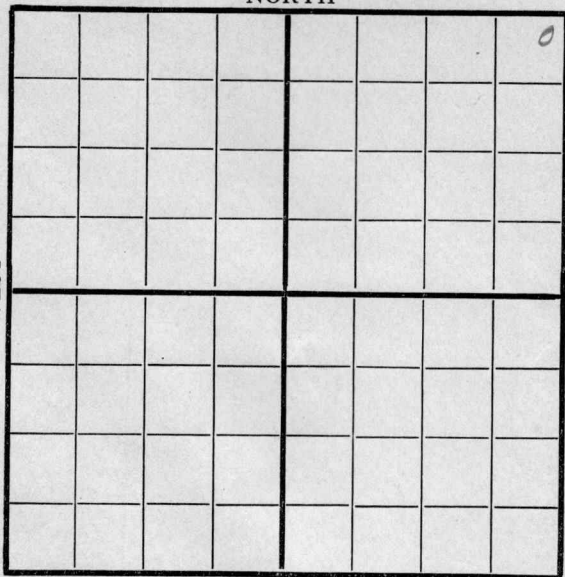

SOUTH

240 N-E

Location _____

Rig up _____

Drilling and Remarks:

Rig up

RECORD

Cased _____ in., _____ ft.

Sand _____

Gas _____

Oil _____

Total Depth _____

PRODUCTION

1st 24 hrs. Nat. _____

1st 24 hrs. after shot _____

Gas _____ Cu. Ft.

Dry Hole _____

Abandoned _____

Date

7/21 1919Cytle Scout

Map No. K11 Sec. 12 Twp. 28 R. 4Well No. 1 HallaceNational Ref. Company

Contractor


SECTION PLAT

240 Ft. from N. Line

Ft. from S. Line

240 Ft. from E. Line

Ft. from W. Line

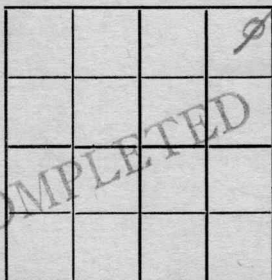

Location

Rig up

Drilling and Remarks:

*Light show @
1915-1919 in
sandy lime*

RECORD

Cased _____ in., _____ ft.

Sand _____

Gas _____

Oil _____

Total Depth _____

PRODUCTION

1st 24 hrs. Nat. _____

1st 24 hrs. after shot _____

Gas _____ Cu. Ft.

Dry Hole 2752

Abandoned _____

Date

10/10 1919

Pyle

Scout

Butler
 K11 KANSAS SEC. *12* TWP. *28S* R. *1E*

WELL NO. *1*
Wallace
National Oil COMPANY

CONTRACTOR

ABANDONED

SECTION PLAT

_____ FT. FROM N. LINE

_____ FT. FROM S. LINE

_____ FT. FROM E. LINE

_____ FT. FROM W. LINE

LOCATION _____

RIG UP _____

DRILLING AND REMARKS:

RECORD

CASED _____ IN. _____ FT.

SAND _____

GAS _____

OIL _____

TOTAL DEPTH *2750*

PRODUCTION

1ST 24 HRS. NAT. _____

1ST 24 HRS. AFTER SHOT _____

GAS _____ CU. FT.

DRY HOLE ☒

ABANDONED ☒

DATE

10/15 19*21* SCOUT