

Map No. KANSAS Sec. 8 Twp. 24 R. 12
Well No. 2- Helson Farm
Mathews & Rex Company

WEST

EAST

SOUTH

Drilling Remarks

PRODUCTION

Abandoned.....

Map No. **KANSAS** Sec. 8 Twp. 24 R. 12^E


Well No. 2 - Nelson Farm
Mathews & Rex Company

 Ft. from N. Line

660 Ft. from S. Line

1070 Ft. from E. Line

 Ft. from W. Line

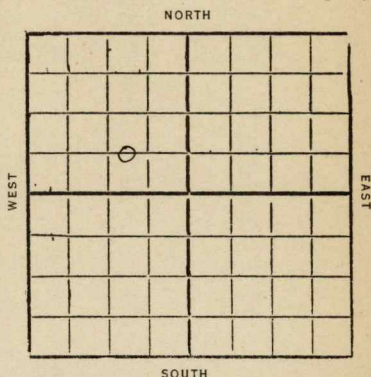

1932

Date

REPORT

6/1	Machine
6/8	Dreg 525
6/15	" 1040'
6/22	" 1550'
6/29	Sand 1710-36
	TD 1737
	shot 100 qt 1711-37
	1100 ft oil in hole
	Cly out
7/6	Sand 1710-36
	TD 1737
	shot 100 qt 1711-37
	Jump 185 bbl 24 hr
	Comp.

Greenwood

 16 **KANSAS** Map No. _____ Sec. 8 Twp. 24 R. 12 ^E

 Well No. 2 Wilson
Matthews & Rex Company

Contractor

FIRST REPORTS**SECTION PLAT**

_____ Ft. from N. Line

660 Ft. from S. Line1070 Ft. from E. Line

_____ Ft. from W. Line

	0		

Location _____

Rig up _____

Drilling and Remarks:

Machins**RECORD**

Cased _____ in., _____ ft.

Sand _____

Gas _____

Oil _____

Total Depth _____

PRODUCTION

1st 24 hrs. Nat. _____

1st 24 hrs. after shot _____

Gas _____ Cu. Ft.

Dry Hole _____

Abandoned _____

Date

JUN 1 1932

CHAS. L. SHERWOOD

192

Scout

16 **KANSAS** *Greenwood*
 Map No. _____ Sec. *8* Twp. *24* R. *12*
 Well No. *2* *Wilson*
Matthews & Rev Company

Contractor _____

COMPLETED**SECTION PLAT**

	0		

_____Ft. from N. Line

660 Ft. from S. Line*1070* Ft. from E. Line

_____Ft. from W. Line

Location _____

RECORD

Cased _____ in., _____ ft.

Rig up _____ Sand *1710-1736*

Drilling and Remarks: _____ Gas _____

Oil _____

Total Depth *1737***PRODUCTION**

1st 24 hrs. Nat. _____

1st 24 hrs. after shot _____

Gas _____ Cu. Ft.

Dry Hole _____

Abandoned _____

Date

JUL 6 1932 CHAS. L. SHERWOOD

_____192_____ Scout