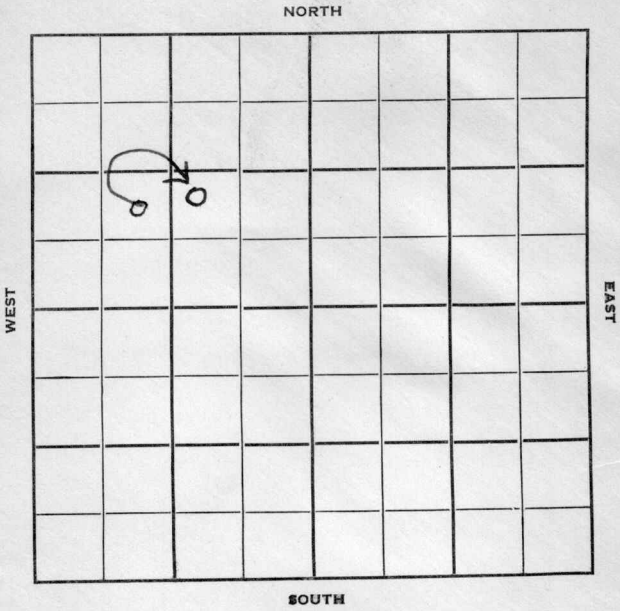


Section 14 Township 28 Range 4-EWell No. #3 MoyleCompany H & M Drlg.

Butler

KANSAS

Sec. 14 Twp. 28 R. 4E ✓

Well No. #3 Moyle Farm

H & M Drlg.

Company

Contractor

Ft. from N. Line

800
~~990~~


Ft. from S. Line

Ft. from E. Line

1500
~~990~~

Ft. from W. Line

~~NW SE~~
~~NE SW NW~~

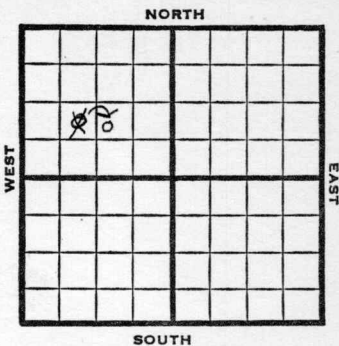

1950

Elev 1295

REPORT

7/5 Rig up

8/16 13" @ 732

8" @ 1847

KC 2063

7" @ 2065

SO 2080-85

5" @ 2554

Simp 2554-71

TD 2576

Comp 40 bo 600 bwpd

Completed

COMPLETED

Map No. _____ Sec. 14 Twp. 28 R. 4EWell No. 3 Moyle

_____ H & M Drlg. _____ Company

_____ Contractor

NE SW NW

SECTION PLAT



_____ Ft. from N. Line

990 Ft. from S. Line

_____ Ft. from E. Line

990 Ft. from W. Line

Butler County

Location _____

Rig up X

Drilling and Remarks:

RECORD

Cased _____ in., _____ ft.

Sand _____

Gas _____

Oil _____

Total Depth _____

PRODUCTION

1st 24 hrs. Nat. _____

1st 24 hrs. after shot _____

Gas _____ Cu. Ft.

Dry Hole _____

Abandoned _____

Date

JUL 5 1950J. E. TYRA Scout

Kansas

Map No. _____ Sec. 14 Twp. 28 R. 4EWell No. 3 Moyle

_____ H & M Drlg. _____ Company

_____ Contractor


NW SE NW

SECTION PLAT

_____ Ft. from N. Line

800 Ft. from S. Line

_____ Ft. from E. Line

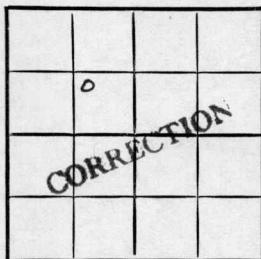1500 Ft. from W. Line

Butler County

Location _____

Rig up _____

Drilling and Remarks:

Reported

NE SW NW

RECORD

Cased _____ in., _____ ft.

Sand _____

Gas _____

Oil _____

Total Depth _____

PRODUCTION

1st 24 hrs. Nat. _____

1st 24 hrs. after shot _____

Gas _____ Cu. Ft.


Dry Hole _____

Abandoned _____

Date

JUL 12 1950 19 J. E. TYRA Scout

County Butler State Kansas
 Sec. 14 (Blk. 28) (Sur. 4E) Map No. 28
 Operator H & M Drlg.
 Well No. 3 Farm Moyle
 Elev. 1295 Location NW SE NW

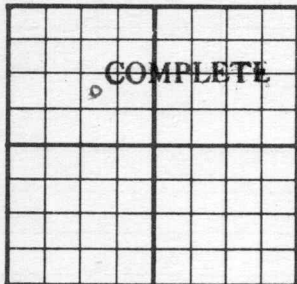

800 Ft. From S Line NW
1500 Ft. From W Line Quarter

1st. Report

Completion AUG 16 1950

Remarks

Spudding Date

Drlg. Data Oil well TD 2576
13" @ 732 8" @ 1847 KC 2063
7" @ 2065 SO 2080-85 5" @ 2554
Simp. 2554-71 TD 2576
Comp. 40 bo 600 bwpd

J. E. TYRA