


Section 14 Township 28 Range 4-EWell No. #4 MoyleCompany H & M Drlg.

NORTH

WEST

EAST

SOUTH

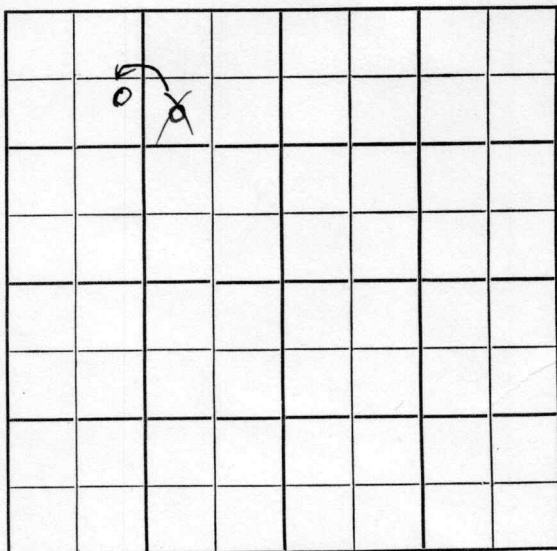

Butler

KANSAS

Sec. 14 Twp. 28 R. 4E

Well No. #4 Moyle Farm

H & M Drlg. Company

Contractor

720'

990'

Ft. from N. Line

Ft. from S. Line


990'

Ft. from E. Line

1200'

Ft. from W. Line

SW NE NW  
SE NW NW

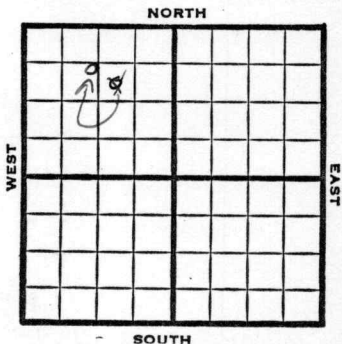

1950

Elev 1300' REPORT

11/8 Drlg. for gas well  
Spud 11-7-50

12/13 Spud 11-7-50  
10" @ 422  
Sand 1823  
TD 1823  
PB 1345  
7" @ 1345  
Comp for gas well for lease use  
Completed

COMPLETED



Kansas

Map No. \_\_\_\_\_ Sec. 14 Twp. 28 R. 4EWell No. 4 Moyle

H &amp; M Drlg. \_\_\_\_\_ Company

**CORRECTION**\_\_\_\_\_  
Contractor

SE NW NW


NOV 15 1950

## SECTION PLAT

720 Ft. from N. Line

\_\_\_\_\_ Ft. from S. Line

\_\_\_\_\_ Ft. from E. Line

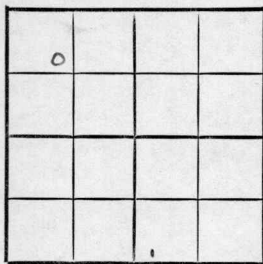1200 Ft. from W. Line

Butler County

Location \_\_\_\_\_

Rig up \_\_\_\_\_

Drilling and Remarks:

Reported

SW NE NW

## RECORD

Cased \_\_\_\_\_ in., \_\_\_\_\_ ft.

Sand \_\_\_\_\_

Gas \_\_\_\_\_

Oil \_\_\_\_\_

Total Depth \_\_\_\_\_

## PRODUCTION

1st 24 hrs. Nat. \_\_\_\_\_

1st 24 hrs. after shot \_\_\_\_\_

Gas \_\_\_\_\_ Cu. Ft.

Dry Hole \_\_\_\_\_

Abandoned \_\_\_\_\_

Date

NOV 15 1950

19

J. E. TYRA Scout

