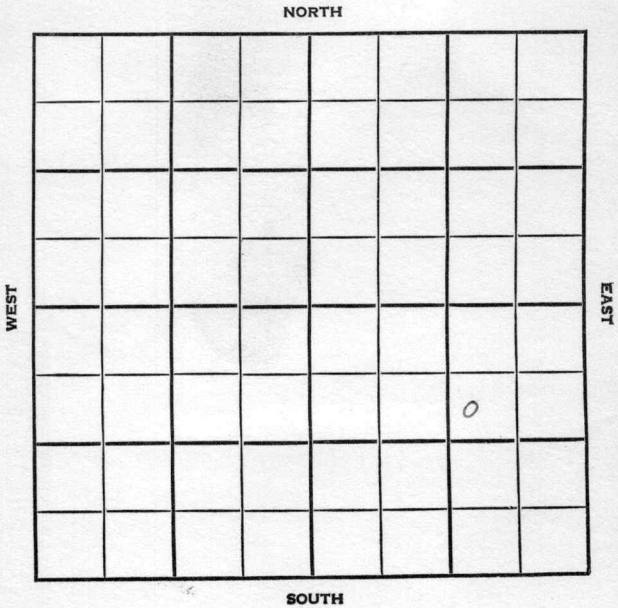


Butler

Section 14 Township 28 Range 4EWell No. #4 Moyle SkaerCompany H & M Drlg.

Butler

KANSAS

SEC.	TWP.	R.
14	28	4E

WELL NO.

x 4 Moyle Skaer

FARM

COMPANY

H & M Drlg.

CONTRACTOR

Co. Tools
Augusta

780'

Ft. from N. Line


Ft. from S. Line

730'

Ft. from E. Line

Ft. from W. Line

SW NE SE

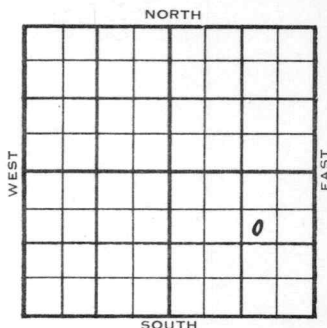

1955

ELEVATION

REPORT

6/15

Comm 6-7-55

8" @ 70/65

5" @ 2670

KC 2090, S. Sh 2600, S. Sd 2617,
A 2628 TD 2670

7/7

CO 6/2648-49 9/2637-39 FU 24' oil
2" wtr in 30" Comp. 25 bopd 5 bw

Top:	Depth	Datum
KC.	2090	783
S. sh.	2600	1293
S. sd.	2617	1310
A.	2628	1321
TD.	2670	

COMPLETED

County Butler Elev. _____
 Sec. 14 Twp. 28 Rge. 4E
 Company H & M Drlg.
 Farm Name Moyle Skaer No. 4

TOPS	DEPTH	LOG	DATUM	Loc. in Sec.
Anh.				SW NE SE
Tp.				780' NL
H.				730' EL
Tr.				
Dg.				
Bl.				
L.				Geol.
M.C.	2090			Contr.
B.K.C.				Co. tools
Ce.				Pool
C.				Augusta
M.				
M.				
K.				
Mz.				
Mq.				
V.				
S. sh	2600			
S. sd	2617			
A	2628			
R.				
Pe.				
G.				
T.D.	2670			

Date Comm. 6-7-55
8" @ 70/65 5" @ 2670

FIRST REPORT

JUN 15 '55

County Butler Elev. 1307
 Sec. 14 Twp. 28 Rge. 4E
 Company H & M Drlg.
 Farm Name Moyle Skaer No. 4

TOPS	DEPTH	LOG	DATUM
Anh.			
Tp.			
H.			
Tr.			
Dg.			
B.L.			
L.			
K.C.	2090		783
B.K.C.			
Ce.			
C.			
M.			
M.			
K.			
Mz.			
Me.			
V.			
S.	sh 2600		1293
S.	sd 2617		1310
A	2628		1321
R.			
Pe.			
G.			
T.D.	2670		

Loc. in Sec. _____

SW NE SE

780' NL

730' EL

Geol. _____

Contr. _____

Co. tools _____

Pool _____

Augusta

COMPLETE

Date Comm. 6-7-55

JUL 6 1955

8" @ 70/65 5" @ 2670 CO 6/ 2648-49

9/ 2637-39 FU 24' oil 2" water in 30"

Comp. 25 bopd 5 bw