


Map No. _____ Sec. 14 Twp. 28 R. XWell No. 3 Shreeves Farm __________ Ohio Company _____

NORTH

WEST

EAST

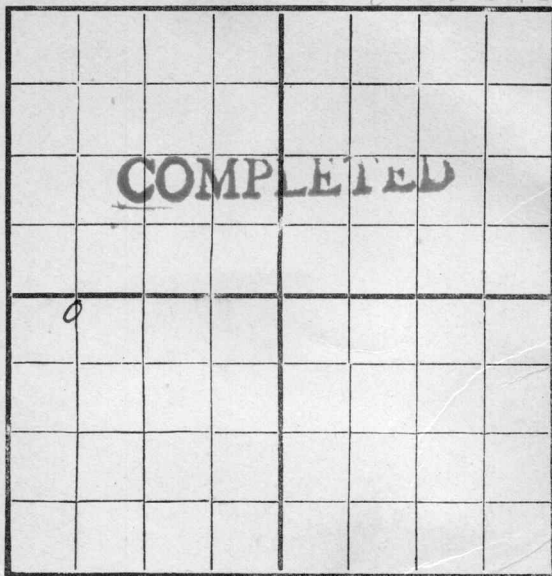

SOUTH

Location _____

Rig Up _____

Drilling Remarks:

Drilling Remarks:

RECORD

Cased _____ in _____ Ft.

Sand _____

Gas _____

Oil _____

Total Depth _____

PRODUCTION

1st 24 hrs. Nat. _____

1st 24 hrs. after shot _____

Gas _____ Cu. Ft.

Dry Hole _____


Abandoned _____

Map No. K 11 Sec. 14 Twp. 28 R. 4
 Well No. 3 Shreeves Farm
Oliver Company

NORTH

WEST

EAST

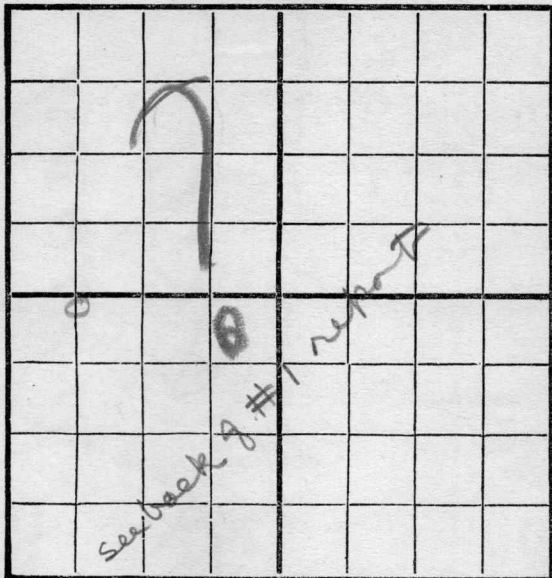

SOUTH

Location _____
 Rig Up ☒ _____
 Drilling and remarks _____

FIRST REPORT

Over

RECORD

Cased _____ in. _____ Ft.
 Sand _____
 Gas _____
 Oil _____
 Total Depth _____

PRODUCTION

1st 24 hrs. Nat. _____
 First 24 hrs. after shot _____
 Gas _____ Cu. Ft.
 Dry Hole _____
 Abandoned _____


Date 2/26, 191 7 Leidy Scout ☒

We have a #3 a Gasser
in this 1/4 Sec

Please state if this is a well close to old one
or correct #

Map No. _____ Sec. 14 Twp. 28 R. 4
 Well No. 3 shreves Farm _____
Ohio Company _____

NORTH

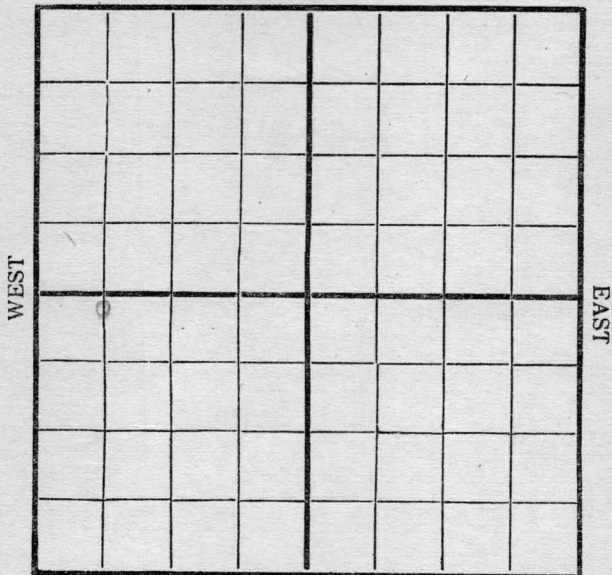

SOUTH

REMARKS:

Rig


Date

3/5, 1917 Cord Scout

Map No. _____ Sec. 14 Twp. 28 R. 4
 Well No. 3 Shreene Farm _____
Oliver Company _____

NORTH

WEST

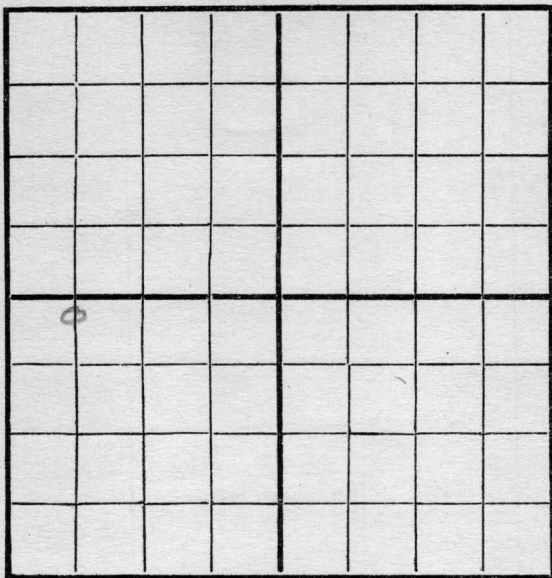

EAST

SOUTH

Location _____
 Rig Up _____
 Drilling and remarks

Spudding

RECORD

Cased _____ in. _____ Ft.
 Sand _____
 Gas _____
 Oil _____
 Total Depth _____

PRODUCTION


1st 24 hrs. Nat. _____
 1st 24 hrs. after shot _____
 Gas _____ Cu. Ft.
 Dry Hole _____
 Abandoned _____

Date

3/12 191 7 *Conley* Scout

Map No. _____ Sec. 14 Twp. 28 R. 4
Well No. 3 Shreene Farm _____
Ohio Company _____

NORTH

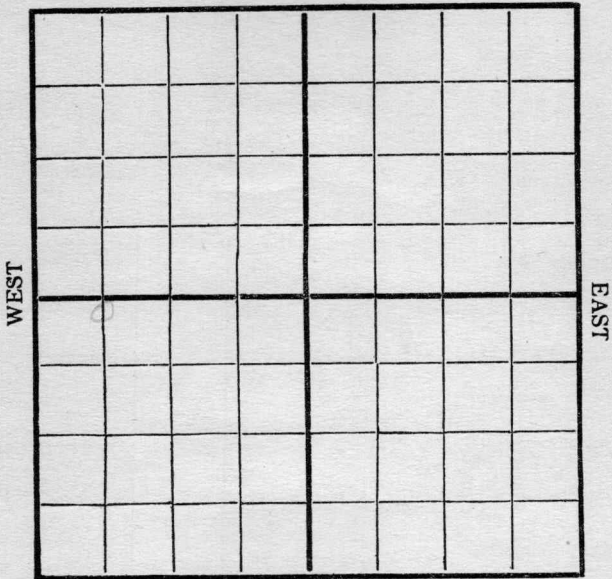

SOUTH

Location _____
Rig Up _____
Drilling and remarks

610'

RECORD

Cased _____ in. _____ Ft.
Sand _____
Gas _____
Oil _____
Total Depth _____

PRODUCTION


1st 24 hrs. Nat. _____
1st 24 hrs. after shot _____
Gas _____ Cu. Ft.
Dry Hole _____
Abandoned _____

Date

3/19, 1917 Cordiff Scout

Map No. _____ Sec. 14 Twp. 28 R. 4
 Well No. 3 Shreene Farm _____
Ohio Company _____

NORTH

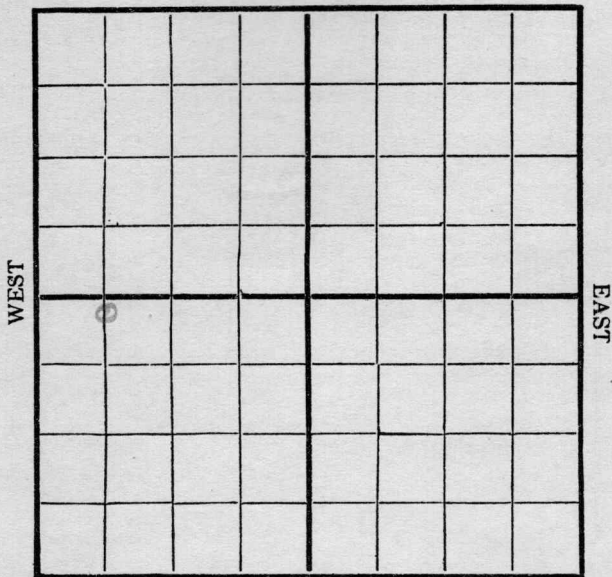

SOUTH

Location _____
 Rig Up _____
 Drilling and remarks _____

1330'

RECORD

Cased _____ in. _____ Ft.
 Sand _____
 Gas _____
 Oil _____
 Total Depth _____


PRODUCTION

1st 24 hrs. Nat. _____
 1st 24 hrs. after shot _____
 Gas _____ Cu. Ft.
 Dry Hole _____
 Abandoned _____

Date 3/26, 1917 Conley Scout

Map No. _____ Sec. 14 Twp. 28 R. 4
 Well No. 3 Shreeves Farm _____
Olin Company _____

NORTH

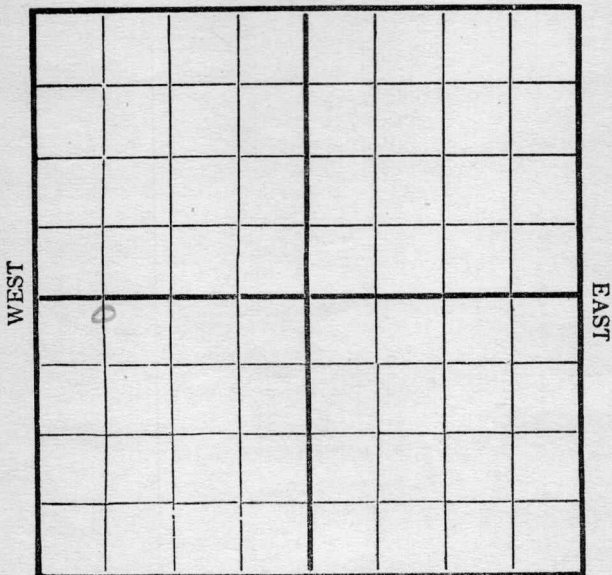

SOUTH

Location _____
 Rig Up _____
 Drilling and remarks _____

1400'

RECORD

Cased _____ in. _____ Ft.
 Sand _____
 Gas _____
 Oil _____
 Total Depth _____

PRODUCTION


1st 24 hrs. Nat. _____
 First 24 hrs. after shot _____
 Gas _____ Cu. Ft.
 Dry Hole _____
 Abandoned _____

Date

4/4, 1917 Cardy Scout

Map No. _____ Sec. 14 Twp. 38 R. 4
Well No. 3 Shreener Farm _____
Olivia Company _____

NORTH

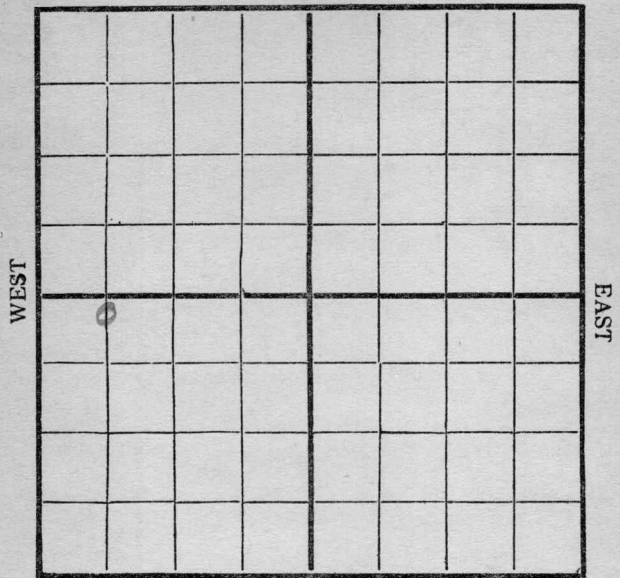

SOUTH

Location _____
Rig Up _____
Drilling and remarks
2200'

RECORD

Cased _____ in. _____ Ft.
Sand _____
Gas _____
Oil _____
Total Depth _____

PRODUCTION

1st 24 hrs. Nat. _____
1st 24 hrs. after shot _____
Gas _____ Cu. Ft.
Dry Hole _____
Abandoned _____


Date 4/10, 1917 Conley Scout

Map No. _____ Sec. 14 Twp. 28 R. 4
 Well No. 3 Shreve Farm _____
Ohio Company _____

NORTH

WEST

EAST

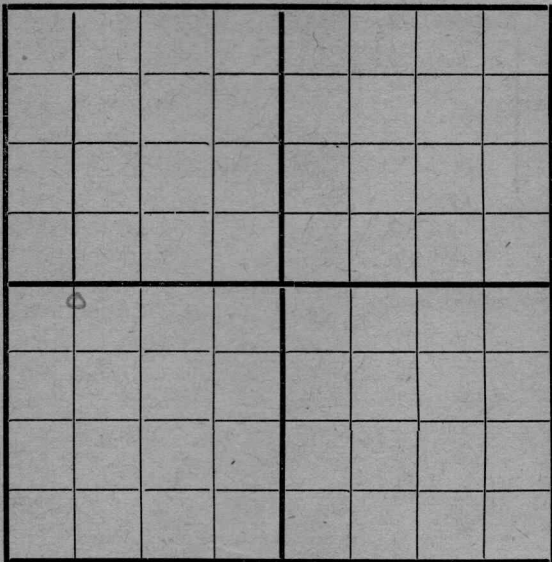

SOUTH

Location _____
 Rig Up _____
 Drilling and remarks

2275'
Sealing

RECORD

Cased _____ in. _____ Ft.
 Sand _____
 Gas _____
 Oil _____
 Total Depth _____

PRODUCTION


1st 24 hrs. Nat. _____
 1st 24 hrs. after shot _____
 Gas _____ Cu. Ft.
 Dry Hole _____
 Abandoned _____

Date

4/17, 1917, C. D. J. Scout

Map No. _____ Sec. 14 Twp. 28 R. 4
 Well No. 3 Shreve Farm _____
Oliver Company _____

NORTH

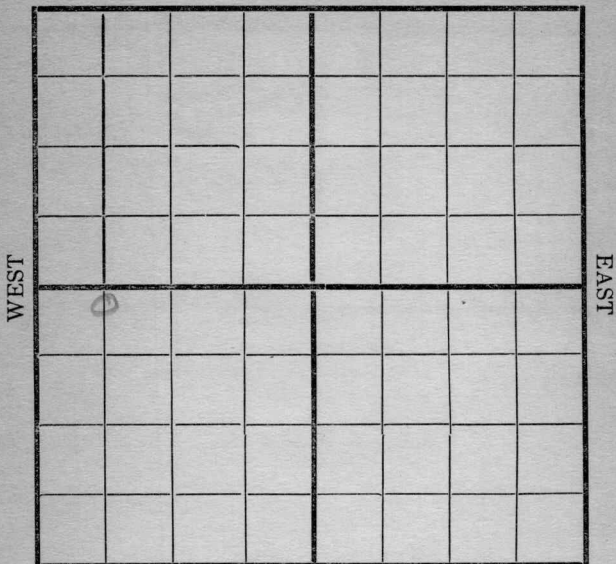

SOUTH

Location _____
 Rig Up _____
 Drilling and remarks

RECORD
 Cased _____ in. _____ Ft.
 Sand _____
 Gas _____
 Oil _____
 Total Depth _____

PRODUCTION
 1st 24 hrs. Nat. _____
 1st 24 hrs. after shot _____
 Gas _____ Cu. Ft.
 Dry Hole _____
 Abandoned _____


Date 4/24, 1917 T. Corbett Scout

Map No. _____ Sec. 14 Twp. 28 R. 4
 Well No. 3 shreve Farm _____
Ohio Company _____

NORTH

WEST

EAST

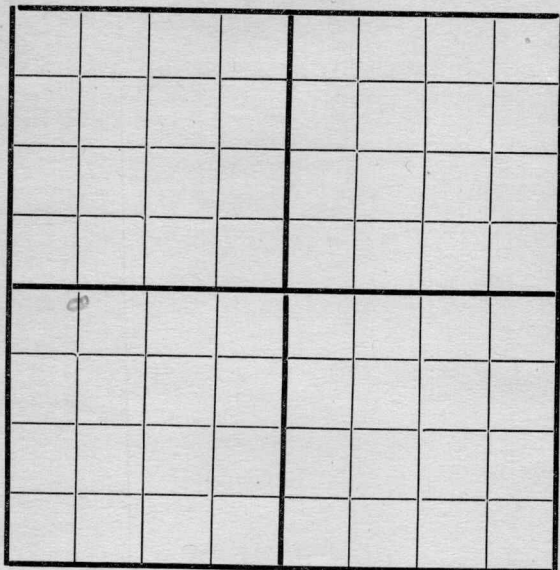

SOUTH

Location _____
 Rig Up _____
 Drilling and remarks _____

Tip sample
1 2548

RECORD

Cased _____ in. _____ Ft.
 Sand _____
 Gas _____
 Oil _____
 Total Depth _____

PRODUCTION


1st 24 hrs. Nat. _____
 1st 24 hrs. after shot _____
 Gas _____ Cu. Ft.
 Dry Hole _____
 Abandoned _____

Date

3/2, 191 2 encl Scout

Map No. _____ Sec. 14 Twp. 28 R. 4
 Well No. 3 Shrees Farm _____
Olive Company _____

NORTH

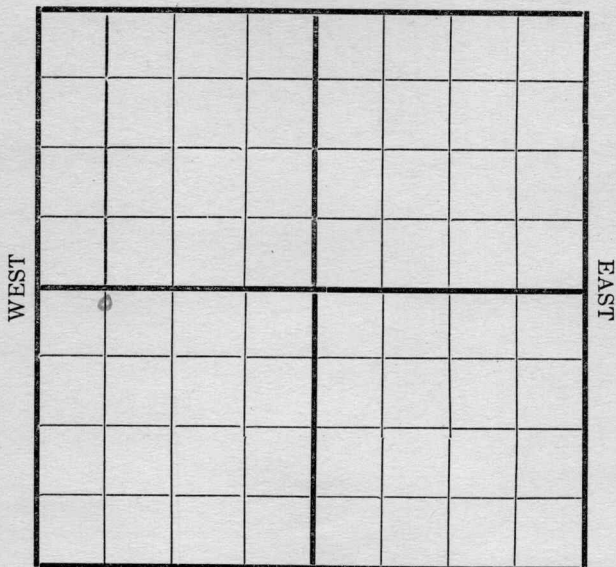

SOUTH

Location _____
 Rig Up _____
 Drilling and remarks _____

Top sand
2548
Running over
2567
Oliver drilling

RECORD

Cased _____ in. _____ Ft.
 Sand _____
 Gas _____
 Oil _____
 Total Depth _____

PRODUCTION

1st 24 hrs. Nat. _____
 1st 24 hrs. after shot _____
 Gas _____ Cu. Ft.
 Dry Hole _____
 Abandoned _____

Date _____

5/8, 191 7 Carling Scout

Map No. _____ Sec. 14 Twp. 28 R. 4Well No. 3 Shireen Farm _____

_____ Company _____

NORTH

WEST

COMPLETED

EAST

SOUTH

Location _____

Rig Up _____

Drilling and remarks

Estimated
at 40 0130e

RECORD

Cased _____ in. _____ Ft.

Sand 2548-2567

Gas _____

Oil _____

Total Depth _____

PRODUCTION

1st 24 hrs. Nat. _____

1st 24 hrs. after shot _____

Gas _____ Cu. Ft.

Dry Hole _____

Abandoned _____

Date

7/25, 1912 Carby Scout