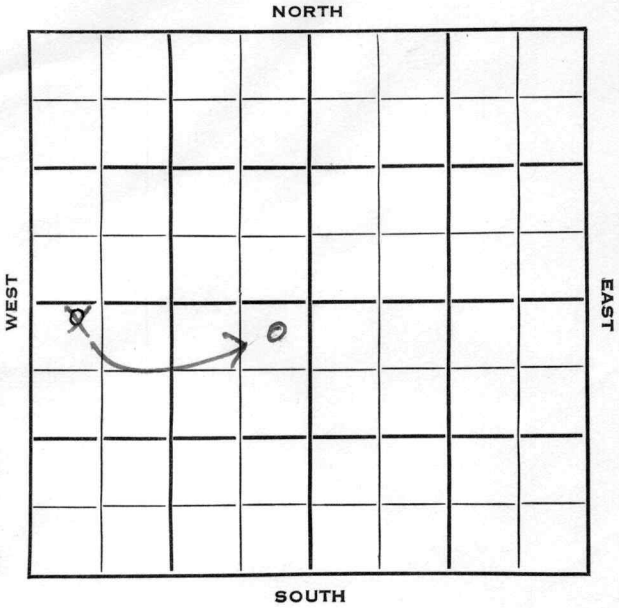


FORM 51

Section 14 Township 28 Range 4EWell No. 4 ShreveCompany H & M Drlg.

Butler
28KANSAS
4ESec. 14 Twp. _____ R. _____Well No. #4 Shreve Farm _____

H & M Drlg.

Company _____

H & M Drlg.

Contractor _____


80 Ft. from N. Line

_____ Ft. from S. Line

550 Ft. from E. Line550 Ft. from W. Line

NENE SW

NW NW SW

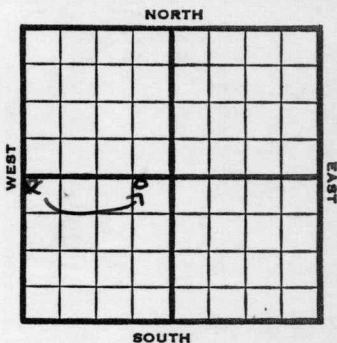

1953

Elev. 1303'

REPORT

4/8

MIR

7/29

Spud 4-8-53

Oil Well

TD 2568

10" @ 28

KC 2080, Simp 2559,

TD 2560

7" @ 2559

DD 2568, FU 10 bwph scum oil

S/6 boph 10 bw

Comp. 25 bopd 50 bw

COMPLETED

J. G. McGEHEE

Kansas

Map No. _____ Sec. 14 Twp. 28 R. 4EWell No. 4 Shreve

H & M Drlg.

Company

CORRECTION

Contractor

NE NE SW

SECTION PLAT

80 Ft. from N. Line

_____ Ft. from S. Line

550 Ft. from E. Line

_____ Ft. from W. Line

	o		

Butler County

Location _____

Rig up _____

Drilling and Remarks:

Reported

NW NW SW

RECORD

Cased _____ in., _____ ft.

Sand _____

Gas _____

Oil _____

Total Depth _____

PRODUCTION

1st 24 hrs. Nat. _____

1st 24 hrs. after shot _____

Gas _____ Cu. Ft.


Dry Hole _____

Abandoned _____

Date

APR 8 1952 19

J. G. McGEHEE Scout

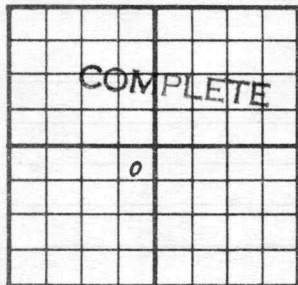County Butler State KansasSec. 14 (Blk.
Twp.) 28 (Sur.
Rge.) 4E Map No.Operator H & M Drlg.Well No. 4 Farm ShreveElev. 1303 Location NE NE SW80 Ft. From N Line SW550 Ft. From E Line Quarter

1st. Report

Completion JUL 29 1953

Remarks

H & M Drlg. - Contr.Spudding Date 4-8-53Drlg. Data Oil well TD 256810" @ 28 KC 2080 Simp. 2559TD 2560 7" @ 2559 DD 2568 FU 10 bwphscum oil S/ 6 boph 10 bwComp. 25 bopd 50 bw