

Map No. _____ Sec. 14 Twp. 28 R. 4

Well No. 5 Shreeves Farm
Ohio (Shreve) Company

NORTH



SOUTH

Location -----

Drilling Remarks:

Rig Up-----

Drilling Remarks:

RECORD

Cased----- in-----Ft.

Sand -----

Gas -----

Oil _____

Total Depth-----

PRODUCTION

1st 24 hrs. Nat-----

1st 24 hrs. after shot-----


Gas_____Cu. Ft.

Dry Hole_____

Abandoned -----

Map No. _____ Sec. 14 Twp. 28 R. 4Well No. 5 Shreeves FarmOhio Company

NORTH

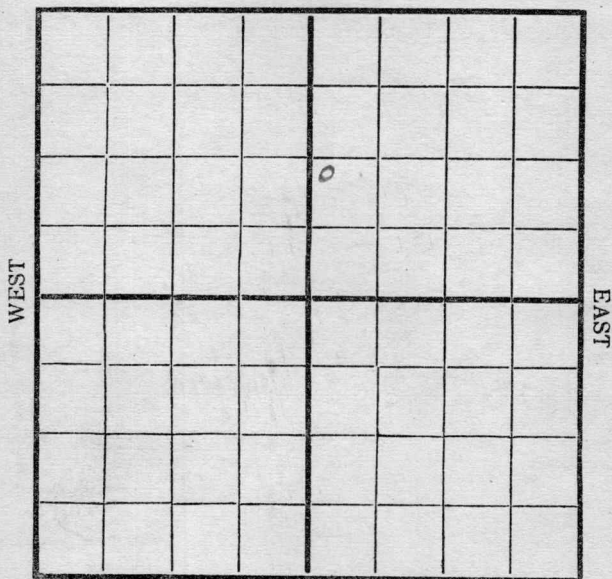

SOUTH

REMARKS: ✓

Rig up

FIRST REPORT

Date

3/12, 1917Cardiff Scout

Map No. _____ Sec. 14 Twp. 28 R. 4
 Well No. 5 Shreeves Farm _____
Ohio Company _____

NORTH

				0			

SOUTH

Location _____
 Rig Up _____
 Drilling and remarks _____

RECORD

Cased _____ in. _____ Ft.
 Sand _____
 Gas _____
 Oil _____
 Total Depth _____

PRODUCTION

1st 24 hrs. Nat. _____
 1st 24 hrs. after shot _____
 Gas _____ Cu. Ft.
 Dry Hole _____
 Abandoned _____

Date

3/19, 1917 Cardiff Scout

Map No. _____ Sec. 14 Twp. 28 R. 4
 Well No. 5 Shreeves Farm _____
Ohio Company _____

NORTH

WEST

EAST

SOUTH

Location ✓
 Rig Up ✓
 Drilling and remarks

RECORD

Cased _____ in. _____ Ft.
 Sand _____
 Gas _____
 Oil _____
 Total Depth _____

PRODUCTION

1st 24 hrs. Nat. _____
 1st 24 hrs. after shot _____
 Gas _____ Cu. Ft.
 Dry Hole _____
 Abandoned _____

Date

3/26, 1917 Cordell Scout

Map No. _____ Sec. 14 Twp. 28 R. 4Well No. 5 Shreeves Farm

_____ Company

NORTH

WEST

EAST

SOUTH

Location _____

Rig Up _____

Drilling and remarks

Rigging

RECORD

Cased _____ in. _____ Ft.

Sand _____

Gas _____

Oil _____

Total Depth _____

PRODUCTION

1st 24 hrs. Nat. _____

First 24 hrs. after shot _____

Gas _____ Cu. Ft.

Dry Hole _____


Abandoned _____

Date

4/4, 191 7. Cordy Scout

Map No. _____ Sec. 14 Twp. 28 R. 4
 Well No. 5 Shreeves Farm _____
Ohio Company _____

NORTH

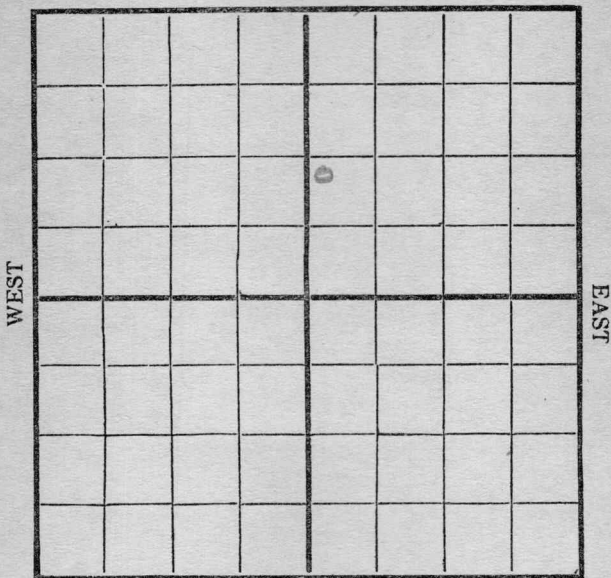

SOUTH

Location _____
 Rig Up _____
 Drilling and remarks _____

Rigged up

RECORD

Cased _____ in. _____ Ft.
 Sand _____
 Gas _____
 Oil _____
 Total Depth _____

PRODUCTION

1st 24 hrs. Nat. _____
 1st 24 hrs. after shot _____
 Gas _____ Cu. Ft.
 Dry Hole _____
 Abandoned _____

Date


4/10, 191 7 Condy Scout

Map No. _____ Sec. 14 Twp. 38 R. 4
 Well No. 5 Shreener Farm _____
Ohio Company _____

NORTH

WEST

EAST

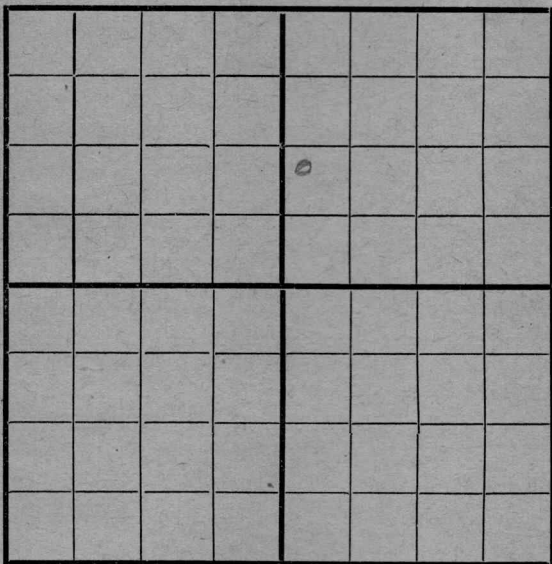

SOUTH

Location _____
 Rig Up _____
 Drilling and remarks _____

RECORD

Cased _____ in. _____ Ft.
 Sand _____
 Gas _____
 Oil _____
 Total Depth _____

PRODUCTION


1st 24 hrs. Nat. _____
 1st 24 hrs. after shot _____
 Gas _____ Cu. Ft.
 Dry Hole _____
 Abandoned _____

Date

4/17, 1917 Condy Scout

Map No. _____ Sec. 14 Twp. 28 R 4
 Well No. 5 Shreener Farm _____
Ohio Company _____

NORTH

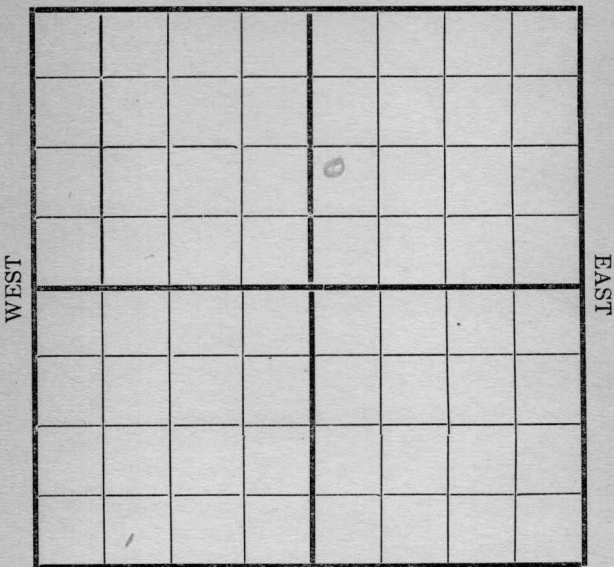

SOUTH

Location _____
 Rig Up ☒ _____
 Drilling and remarks _____

RECORD

Cased _____ in. _____ Ft.
 Sand _____
 Gas _____
 Oil _____
 Total Depth _____

PRODUCTION


1st 24 hrs. Nat. _____
 1st 24 hrs. after shot _____
 Gas _____ Cu. Ft.
 Dry Hole _____
 Abandoned _____

Date

4/24/27 191 Carney Scout

Map No. _____ Sec. 14 Twp. 28 R. 4
 Well No. 5 Shrews Farm _____
Oliver Company _____

NORTH

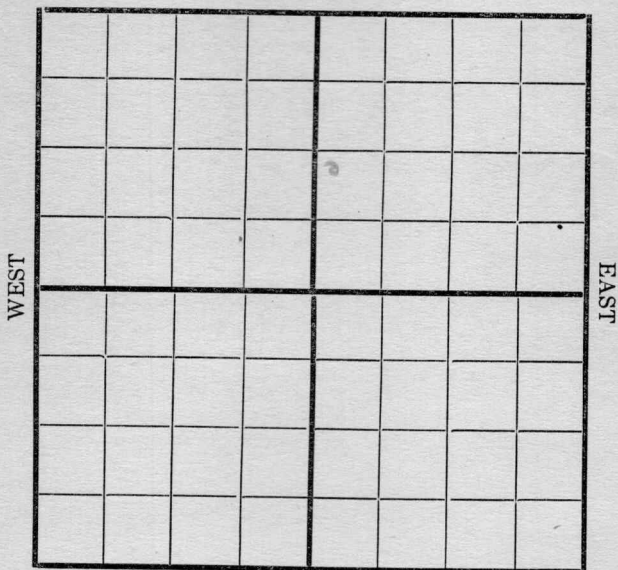

SOUTH

Location _____
 Rig Up _____
 Drilling and remarks _____

RECORD

Cased _____ in. _____ Ft.
 Sand _____
 Gas _____
 Oil _____
 Total Depth _____

PRODUCTION

1st 24 hrs. Nat. _____
 1st 24 hrs. after shot _____
 Gas _____ Cu. Ft.
 Dry Hole _____
 Abandoned _____

Date 5/3, 1917 Carly Scout

Map No. _____ Sec. 14 Twp. 28 R. 4
Well No. 5 Shivers Farm _____
Ohio Company _____

NORTH

WEST

EAST

SOUTH

Location _____

Rig Up ✓ -----

Drilling and remarks

RECORD

Cased-----in. -----Ft.

Sand_____

Gas _____

Oil _____

Total Depth_____

PRODUCTION

1st 24 hrs. Nat.

1st 24 hrs. after shot-----

Gas _____ Cu. Ft.

Dry Hole_____


Abandoned-----

Date _____

5/8, 1917, C. J. ... Scout

Map No. _____ Sec. 14 Twp. 28 R. 4
 Well No. 5-20-28-4 Farm _____
Ohio Company _____

NORTH

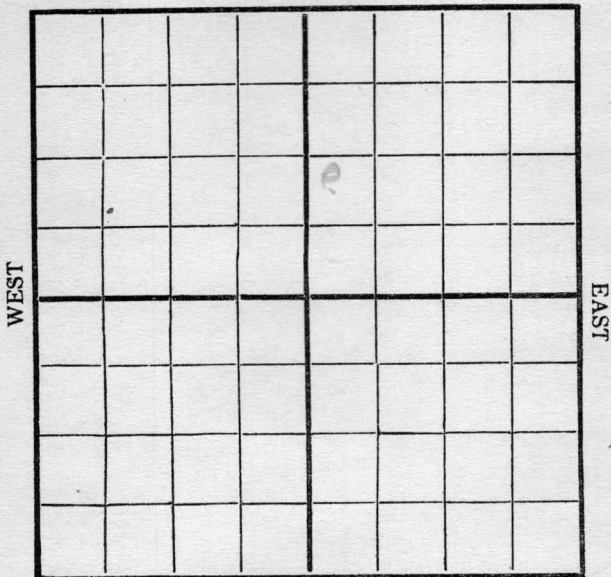

SOUTH

Location _____
 Rig Up _____
 Drilling and remarks _____

RECORD

Cased _____ in. _____ Ft.
 Sand _____
 Gas _____
 Oil _____
 Total Depth _____

PRODUCTION


1st 24 hrs. Nat. _____
 1st 24 hrs. after shot _____
 Gas _____ Cu. Ft.
 Dry Hole _____
 Abandoned _____

Date

5/25-2 191 County Scout

Map No. _____ Sec. 14 Twp. 38 R. 4
 Well No. 5 Shivers Farm _____
Ohio Company _____

NORTH

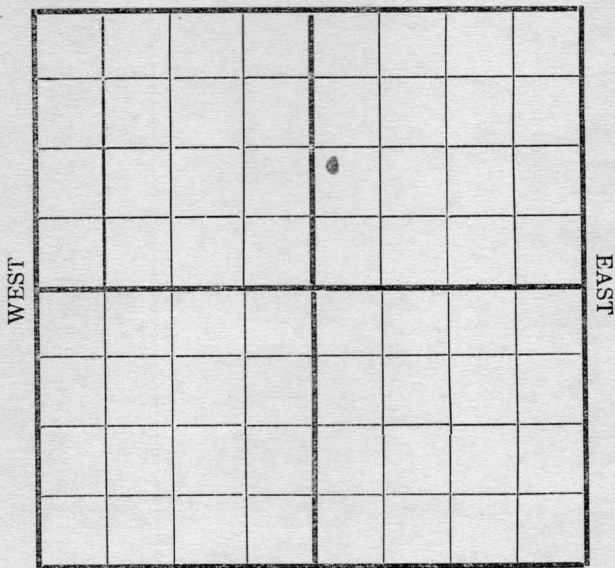

SOUTH

Location _____
 Rig Up ☒ _____
 Drilling and remarks _____

RECORD

Cased _____ in. _____ Ft.
 Sand _____
 Gas _____
 Oil _____
 Total Depth _____

PRODUCTION

1st 24 hrs. Nat. _____
 1st 24 hrs. after shot _____
 Gas _____ Cu. Ft.
 Dry Hole _____
 Abandoned _____

Date 7-29, 1917 Cardiff Scout

Map No. _____ Sec. 29 Twp. 28 R. 4

Well No. 5 Hurdner Farm

_____ Company

NORTH

[illegible]

SOUTH

Location _____

Rig Up ☒

Drilling and remarks

RECORD

Cased_____in. _____Ft.

Sand _____

Gas _____

Oil_____

Total Depth_____

PRODUCTION

1st 24 hrs. Nat. _____

1st 24 hrs. after shot-----

Gas-----Cu. Ft.

Dry Hole_____


Abandoned_ _ _ _ _


191 Scout

Map No. _____ Sec. 14 Twp. 28 R. 4
 Well No. 5 Shiner Farm _____
Ohio Company _____

NORTH

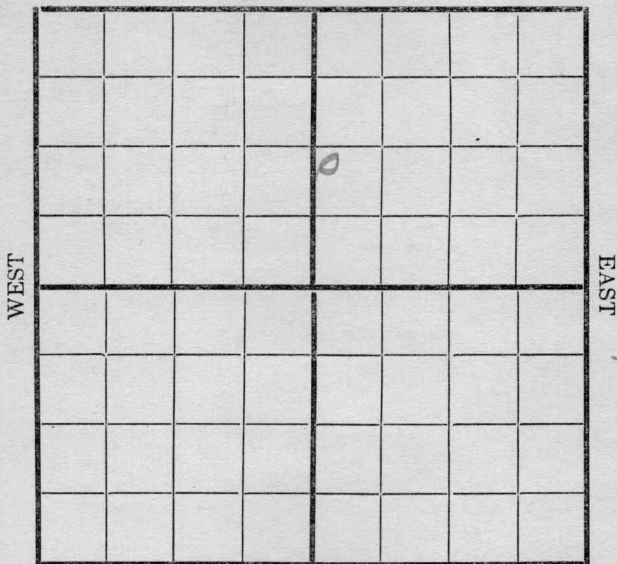

SOUTH

Location _____
 Rig Up _____
 Drilling and remarks _____

Spudding

RECORD

Cased _____ in. _____ Ft.
 Sand _____
 Gas _____
 Oil _____
 Total Depth _____


PRODUCTION

1st 24 hrs. Nat. _____
 1st 24 hrs. after shot _____
 Gas _____ Cu. Ft.
 Dry Hole _____
 Abandoned _____

Date 6/12, 1917 C. C. C. C. Scout _____

Map No. _____ Sec. 44 Twp. 28 R. 4
 Well No. 5 _____ Farm _____
Olin _____ Company _____

NORTH

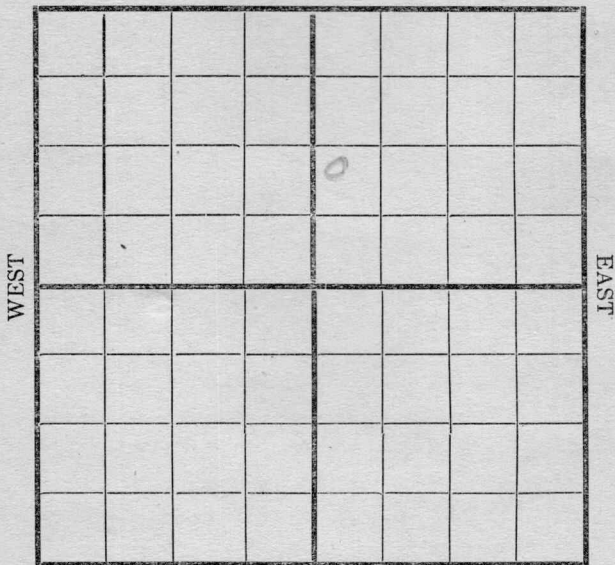

SOUTH

Location _____
 Rig Up _____
 Drilling and remarks _____

RECORD

Cased _____ in. _____ Ft.
 Sand _____
 Gas _____
 Oil _____
 Total Depth _____

PRODUCTION


1st 24 hrs. Nat. _____
 1st 24 hrs. after shot _____
 Gas _____ Cu. Ft.
 Dry Hole _____
 Abandoned _____

Date

6/20, 191 7 Candy Scout

Map No. _____ Sec. 14 Twp. 28 R. 4
 Well No. 5 Shreener Farm _____
Oliver Company _____

NORTH

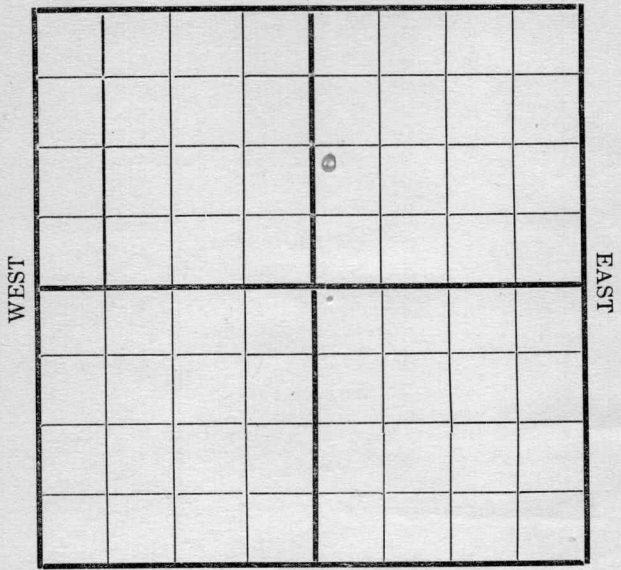

SOUTH

Location _____
 Rig Up _____
 Drilling and remarks

450

RECORD

Cased _____ in. _____ Ft.
 Sand _____
 Gas _____
 Oil _____
 Total Depth _____

PRODUCTION


1st 24 hrs. Nat. _____
 1st 24 hrs. after shot _____
 Gas _____ Cu. Ft.
 Dry Hole _____
 Abandoned _____

Date 6/30 191 7 Parley Scout

Map No. _____ Sec. 14 Twp. 28 R. 4Well No. 5 Shiner Farm _____Ohio Company _____

NORTH

WEST

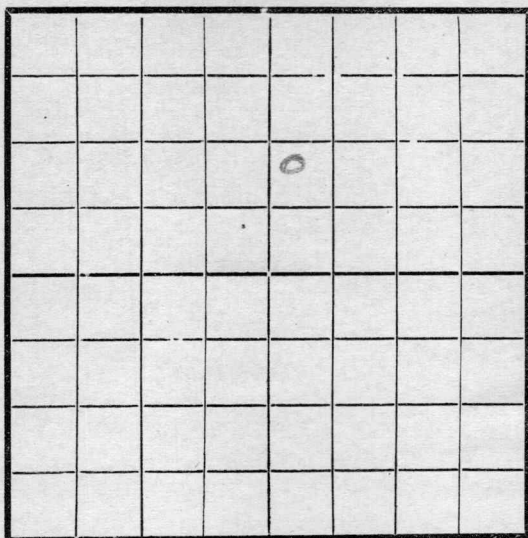

EAST

SOUTH

Location _____

Rig Up _____

Drilling and remarks

600'

RECORD

Cased _____ in. _____ Ft.

Sand _____

Gas _____

Oil _____

Total Depth _____

PRODUCTION

1st 24 hrs. Nat. _____

1st 24 hrs. after shot _____

Gas _____ Cu. Ft.

Dry Hole _____

Abandoned _____

Date


7/6, 1917 C. C. Cady Scout

Map No. _____ Sec. 14 Twp. 28 R. 4Well No. 5 Shure Farm _____

_____ Company

NORTH

WEST

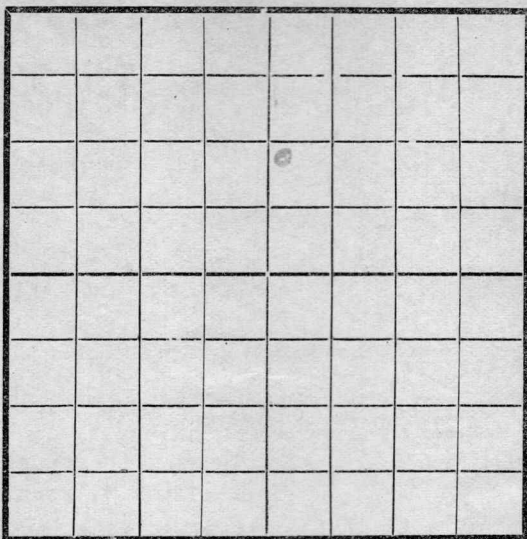

EAST

SOUTH

Location _____

Rig Up _____

Drilling and remarks

RECORD

Cased _____ in. _____ Ft.

Sand _____

Gas _____

Oil _____

Total Depth _____

PRODUCTION

1st 24 hrs. Nat. _____

1st 24 hrs. after shot _____

Gas _____ Cu. Ft.

Dry Hole _____

Abandoned _____


Date

7/27, 1917 Condy Scout

Map No. _____ Sec. 14 Twp. 28 R. 4Well No. 5 Shivers Farm _____Ohio Company _____

NORTH

WEST

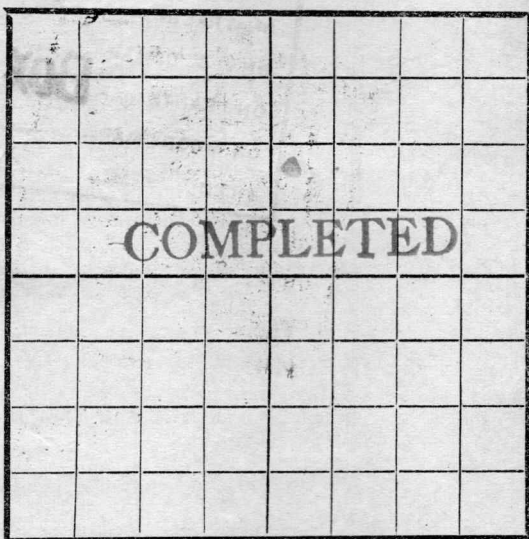

EAST

SOUTH

Location _____

Rig Up _____

Drilling and remarks

Est at
125
Barrels

RECORD

Cased _____ in. _____ Ft.

Sand 2595-2611

Gas _____

Oil _____

Total Depth _____

PRODUCTION

1st 24 hrs. Nat. _____

1st 24 hrs. after shot _____

Gas _____ Cu. Ft.

Dry Hole _____

Abandoned _____

Date

8/17, 1917 Condy Scout