

# STATE CORPORATION COMMISSION OF KANSAS OIL & GAS CONSERVATION DIVISION

## WELL COMPLETION OR RECOMPLETION FORM ACO-1 WELL HISTORY

### DESCRIPTION OF WELL AND LEASE

Operator: license # 6772  
name V. Francis Weigel  
address Box 244  
City State Zip Gorham, KS 67640

Operator Contact Person V. Francis Weigel  
Phone (913)637-5383

Contractor: license # 5655  
name Shields Drilling Co., Inc.

Geologist Francis Whisler  
Phone (913)483-3020

### Designate Type of Completion

XX New Well

Re-Entry

Workover

☒ Oil ☐ SWD ☐ Temp Abd  
☐ Gas ☐ Inj ☐ Delayed Comp.  
☐ Dry ☐ Other (Core, Water Supply etc.)

### If OWWO: old well info as follows:

Operator  
Well Name  
Comp. Date Old Total Depth

### WELL HISTORY

Drilling Method: ☒ Mud Rotary ☐ Air Rotary ☐ Cable

11/15/85 11/20/85 12/13/85  
Spud Date Date Reached TD Completion Date

20' 3316'  
Total Depth PBDT

Amount of Surface Pipe Set and Cemented at 8 5/8" @ 727 feet

Single Stage Cementing Collar Used? ☐ Yes ☒ No

If Yes, Show Depth Set feet

If alternate 2 completion, cement circulated  
from feet depth to w/ SX cmt

API NO. 15 - 167-22,694

County Russell

NW - NE - SE Sec 28 Twp 12s Rge 15 XX West  
(location)

2310 Ft North from Southeast Corner of Section  
990 Ft West from Southeast Corner of Section  
(Note: locate well in section plat below)


Lease Name Gayler Well# 2

Field Name Gayler

Producing Formation Kansas City

Elevation: Ground 1839' KB 1844'

Section Plat

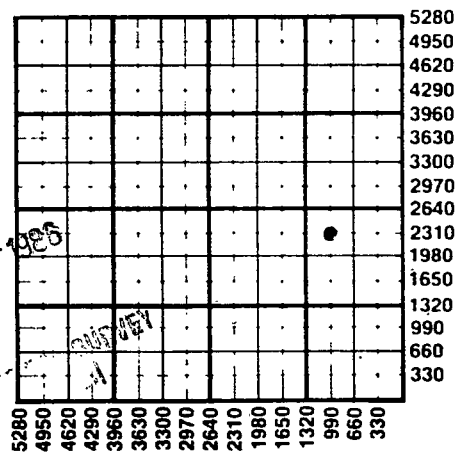

### WATER SUPPLY INFORMATION

Source of Water:

Division of Water Resources Permit #

☐ Groundwater Ft North From Southeast Corner and  
(Well) Ft. West From Southeast Corner of

Sec Twp Rge East West

☐ Surface Water Ft North From Southeast Corner and  
(Stream, Pond etc.) Ft West From Southeast Corner

Sec Twp Rge East West

☐ Other (explain)  
(purchased from city, R.W.D.#)

Disposition of Produced Water: ☐ Disposal  
☐ Repressuring

Docket #

**INSTRUCTIONS:** This form shall be completed in duplicate and filed with the Kansas Corporation Commission, 200 Colorado Derby Building, Wichita, Kansas 67202, within 90 days after completion or recompletion of any well. Rules 82-3-130 and 82-3-107 apply.

Information on side two of this form will be held confidential for a period of 12 months if requested in writing and submitted with the form. See rule 82-3-107 for confidentiality in excess of 12 months.

One copy of all wireline logs and drillers time log shall be attached with this form. Submit CP-4 form with all plugged wells. Submit CP-111 form with all temporarily abandoned wells.

SIDE TWO

NW-NE-SE

☐ East,Operator Name .... V. Francis Weigel..... Lease Name .Gayler..... Well# 2... SEC.28... TWP.12... RGE.15..... ☒ West

## WELL LOG

**INSTRUCTIONS:** Show important tops and base of formations penetrated. Detail all cores. Report all drill stem tests giving interval tested, time tool open and closed, flowing and shut-in pressures, whether shut-in pressure reached static level, hydrostatic pressures, bottom hole temperature, fluid recovery, and flow rates if gas to surface during test. Attach extra sheet if more space is needed. Attach copy of log.

Drill Stem Tests Taken  
Samples Sent to Geological Survey  
Cores Taken

☐ Yes ☒ No  
☐ Yes ☒ No  
☐ Yes ☒ No

Formation Description  
☒ Log ☐ Sample

| Name                | Top   | Bottom |
|---------------------|-------|--------|
| Anhydrite           | 905'  |        |
| Topeka Lime         | 2738' |        |
| Heebner Shale       | 2960' |        |
| Toronto Lime        | 2980' |        |
| Douglas Shale       | 2992' |        |
| Lansing-Kansas City | 3007' |        |
| Base of the K.C.    |       | 3252'  |
| Conglomerate        | 3265' |        |
| Weathered Arbuckle  | 3289' |        |
| T. D.               | 3340' |        |

|   |         |                         |
|---|---------|-------------------------|
| 1 | 3033-36 | None                    |
| 2 | 3009-15 | Acid 2,000 gal 15% Dem. |

**TUBING RECORD** size 2 7/8 set at 3314 packer at none Liner Run ☐ Yes ☒ No

Date of First Production 12/28/85 Producing method ☐ flowing ☒ pumping ☐ gas lift ☐ Other (explain)

| Estimated Production Per 24 Hours | Oil    | Gas | Water    | Gas-Oil Ratio | Gravity |
|-----------------------------------|--------|-----|----------|---------------|---------|
|                                   | 7 Bbls | MCF | 112 Bbls | CFPB          | 36      |

## METHOD OF COMPLETION

## PRODUCTION INTERVAL

Disposition of gas: ☐ vented☐ sold☐ used on lease☐ open hole ☒ perforation☐ other (specify)☐ Dually Completed.☒ Commingled

3009'

3222'

## CASING RECORD

☒ new ☐ used

Report all strings set - conductor, surface, intermediate, production, etc.

type and percent additives

| Purpose of string | size hole drilled | size casing set (in O.D.) | weight lbs/ft. | setting depth | type of cement | # sacks used | type and percent additives |
|-------------------|-------------------|---------------------------|----------------|---------------|----------------|--------------|----------------------------|
| surface           | 12 1/2            | 8 5/8                     | 24#            | 727'          | common         | 350          |                            |
| production        | 7 7/8             | 5 1/2                     | 14#            | 3338          | common         | 150          |                            |

## PERFORATION RECORD

## Acid, Fracture, Shot, Cement Squeeze Record

| shots per foot | specify footage of each interval perforated | (amount and kind of material used) | Depth |
|----------------|---------------------------------------------|------------------------------------|-------|
| 4              | 3220-22                                     | Acid 750 & 1750 gal 15% Dem.       |       |
| 1              | 3188, 3170, 3146                            | Acid 1500 & 4000 15% Dem.          |       |
| 1              | 3052, 3047, 3034                            | Acid 2000 gal 15% Dem.             |       |
| 1              | 3046-54                                     | None                               |       |