


Map No. _____ Sec. 14 Twp. 28 E. 4Well No. 13-Drew Farm __________Ohio_____
Company _____

NORTH

WEST

EAST

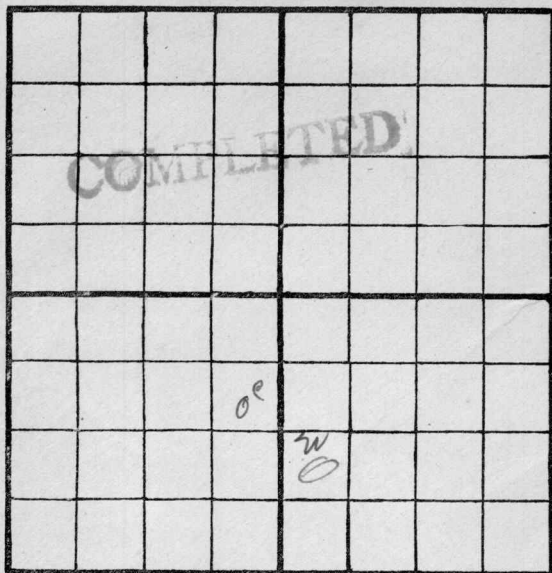

SOUTH

Location _____

Rig Up _____

Drilling Remarks:

Drilling Remarks:

RECORD

Cased _____ in. _____ ft.

Sand _____

Gas _____

Oil _____

Total Depth _____

PRODUCTION

1st 24 hrs. Nat. _____

1st 24 hrs. after shot _____

Gas _____ cu. ft


Dry Hole _____

Abandoned _____

Map No. _____ Sec. 11 Twp. 28 R. 4Well No. 13 Shreves Farm __________ O. L. Co. Company _____

NORTH

WEST

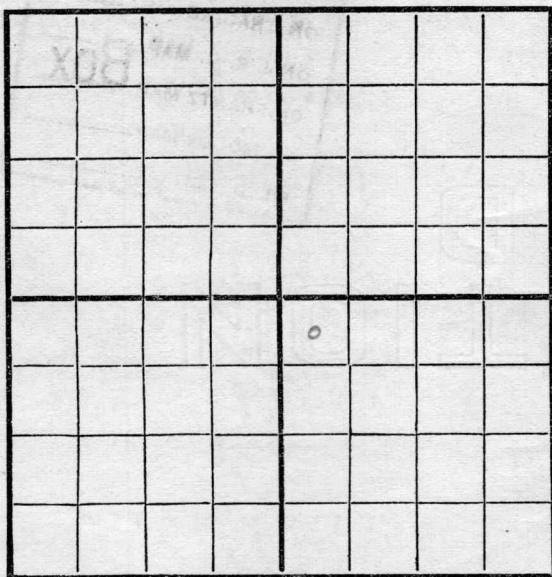

EAST

SOUTH

Location _____

Rig Up _____

Drilling and remarks

300

RECORD

Cased _____ in. _____ Ft.

Sand _____

Gas _____

Oil _____

Total Depth _____

PRODUCTION

1st 24 hrs. Nat. _____

1st 24 hrs. after shot _____

Gas _____ Cu. Ft.

Dry Hole _____

Abandoned _____

FIRST REPORT

Date

8/1

191

7 Cordery

Scout


Map No. K11 Sec. 11 Twp. 28 R. 4

Well No. 13 Shreeves Farm

Oliver Company

NORTH

WEST

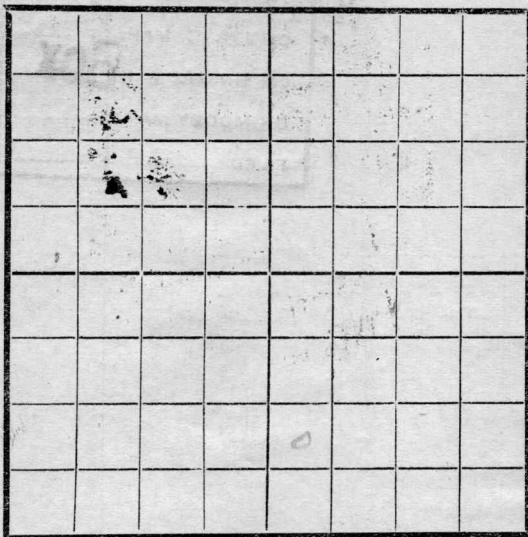

EAST

SOUTH

Location -----

Rig Up -----

Drilling and remarks

450'

FIRST REPORT

RECORD

Cased ----- in. ----- Ft.

Sand -----

Gas -----

Oil -----

Total Depth -----

PRODUCTION

1st 24 hrs. Nat. -----

1st 24 hrs. after shot -----

Gas ----- Cu. Ft.

Dry Hole -----

Abandoned -----

Date

8/17, 1917 Cord Scout


Map No. _____ Sec. 11 Twp. 28 R. 4

Well No. 13. O. Shivers Farm _____

Ohio Company _____

NORTH

WEST

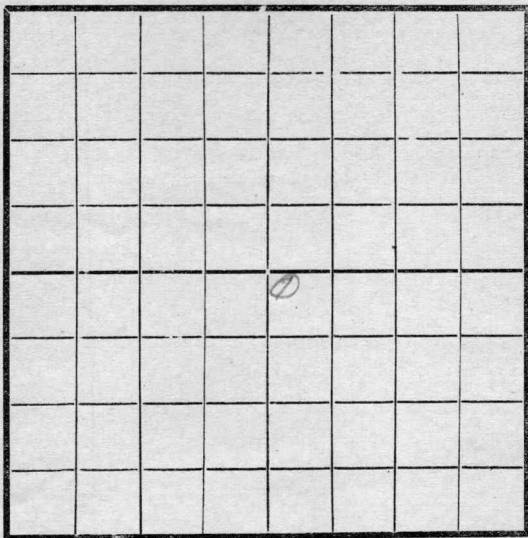

EAST

SOUTH

Location _____

Rig Up _____

Drilling and remarks

at 1200.

RECORD

Cased _____ in. _____ Ft.

Sand _____

Gas _____

Oil _____

Total Depth _____

PRODUCTION

1st 24 hrs. Nat. _____

1st 24 hrs. after shot _____

Gas _____ Cu. Ft.

Dry Hole _____

Abandoned _____

Date


8-20, 1917 Lantz Scout

Map No. _____ Sec. 13 Twp. 28 R. 4Well No. 13 Shreve Farm _____

_____ Company _____

NORTH

WEST

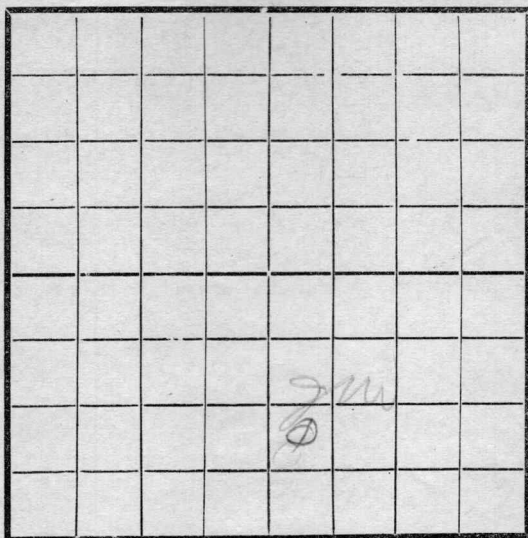

EAST

SOUTH

RECORD

Location _____

Cased _____ in. _____ Ft.

Rig Up _____

Sand _____

Drilling and remarks

Gas _____

Oil _____

Total Depth _____

PRODUCTION

1st 24 hrs. Nat. _____

1st 24 hrs. after shot _____

Gas _____ Cu. Ft.

Dry Hole _____


Abandoned _____

Date

8-20, 1917 Lang Scout

Map No. _____ Sec. 14 Twp. 28 R. 4Well No. 13 Shreeve Farm __________ Ohio Company _____

NORTH

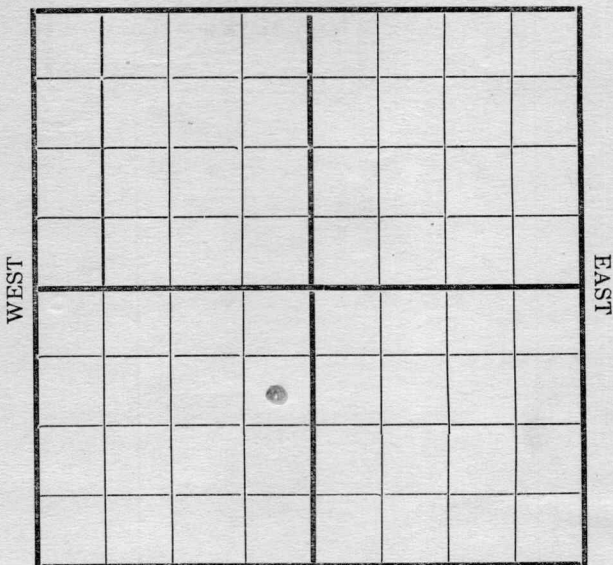

SOUTH

Location _____

Rig Up _____

Drilling and remarks

Correctedlocation#13 Shreeve

RECORD

Cased _____ in. _____ Ft.

Sand _____

Gas _____

Oil _____

Total Depth _____

PRODUCTION

1st 24 hrs. Nat. _____

1st 24 hrs. after shot _____

Gas _____ Cu. Ft.

Dry Hole _____

Abandoned _____


Date

9/14, 1917 Cordiff Scout

Map No. _____ Sec. 14 Twp. 28 R. 4Well No. Shreeves Farm
OHIO OIL Company

NORTH

WEST

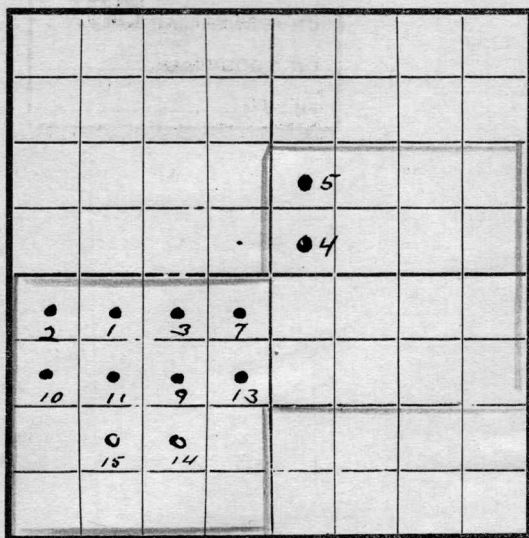

EAST

SOUTH

Location _____

Rig Up _____

Drilling and remarks

Plat showing
location of wells
on Shreeves
Farm in Sec.
14-28-4

RECORD

Cased _____ in. _____ Ft.

Sand _____

Gas _____

Oil _____

Total Depth _____

PRODUCTION

1st 24 hrs. Nat. _____

1st 24 hrs. after shot _____

Gas _____ Cu. Ft.

Dry Hole _____

Abandoned _____

Date

9/26, 1917 Carby Scout

Map No. _____ Sec. 14 Twp. 28 R. 4
 Well No. 13 Shreve Farm _____
Ohio Company _____

NORTH

WEST

EAST

COMPLETED

SOUTH

Location _____

Rig Up _____

Drilling and remarks

Est at
225
1360

RECORD

Cased _____ in. _____ Ft.

Sand 2561-2578

Gas _____

Oil _____

Total Depth _____

PRODUCTION

1st 24 hrs. Nat. _____

1st 24 hrs. after shot _____

Gas _____ Cu. Ft.

Dry Hole _____

Abandoned _____

Date

10/2, 1912, Combs Scout