


Map No. _____ Sec. 14 Twp. 28 R. 4
 Well No. 15 Shreve Farm _____
Ohio Company _____

NORTH

WEST

EAST

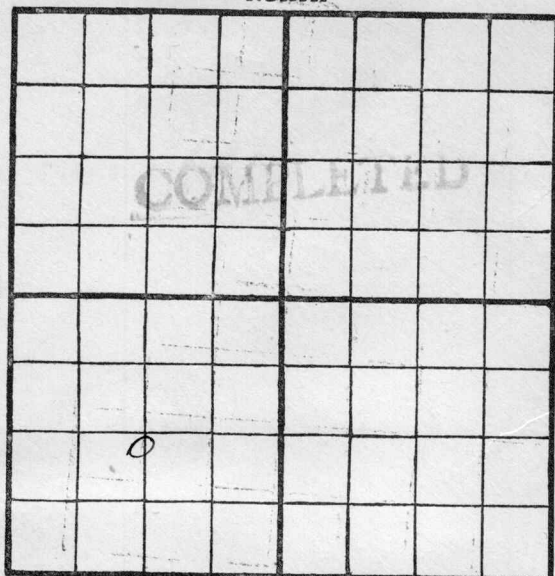

SOUTH

Location _____

Rig Up _____

Drilling Remarks:

Drilling Remarks:

RECORD

Cased _____ in. _____ ft.

Sand _____

Gas _____

Oil _____

Total Depth _____

PRODUCTION

1st 24 hrs. Nat. _____

1st 24 hrs. after shot _____

Gas _____ cu. ft

Dry Hole _____

Abandoned _____


Map No. _____ Sec. 14 Twp. 38 R. 4

Well No. 15. Shreve Farm _____

Ohio Company _____

NORTH

WEST

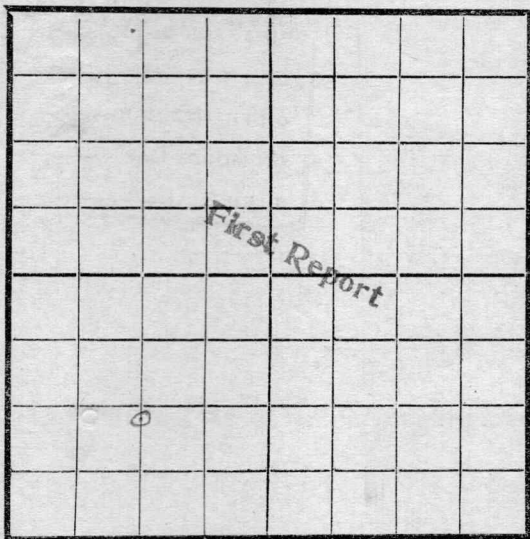

EAST

SOUTH

Location _____

Rig Up ☒ _____

Drilling and remarks _____

RECORD

Cased _____ in. _____ Ft.

Sand _____

Gas _____

Oil _____

Total Depth _____

PRODUCTION

1st 24 hrs. Nat. _____

1st 24 hrs. after shot _____

Gas _____ Cu. Ft.

Dry Hole _____

Abandoned _____


Date

8-27, 1917 Lautz Scout

Map No. _____ Sec. 14 Twp. 28 R. 4Well No. 15 Shreves Farm _____Ohio Company _____

NORTH

WEST

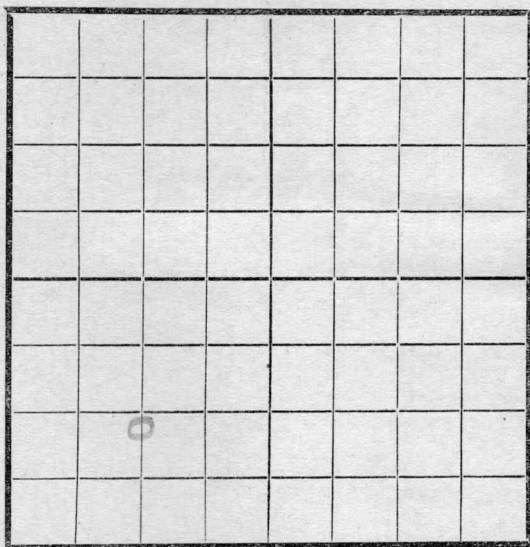

EAST

SOUTH

RECORD

Location _____

Cased _____ in. _____ Ft.

Rig Up ☒ _____

Sand _____

Drilling and remarks _____

Gas _____

Oil _____

Total Depth _____

PRODUCTION

1st 24 hrs. Nat. _____

1st 24 hrs. after shot _____

Gas _____ Cu. Ft.

Dry Hole _____

Abandoned _____


Date

10/9, 1917 Randy Scout _____

Map No. _____ Sec. 14 Twp. 28 R. 4Well No. 15 Shreves Farm __________ Ohio Company _____

NORTH

WEST

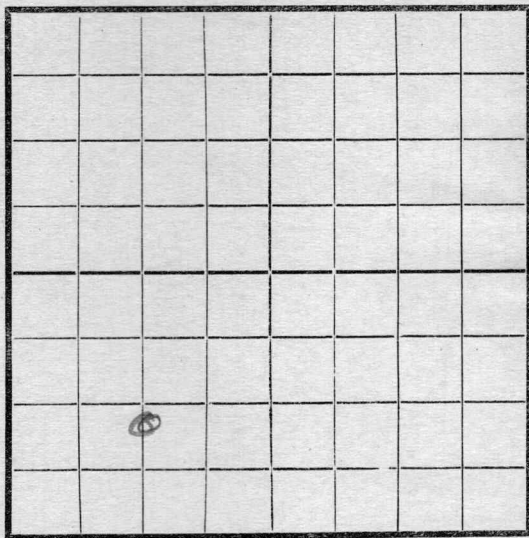

EAST

SOUTH

Location ✓

Rig Up _____

Drilling and remarks _____

RECORD

Cased _____ in. _____ Ft.

Sand _____

Gas _____

Oil _____

Total Depth _____

PRODUCTION

1st 24 hrs. Nat. _____

1st 24 hrs. after shot _____

Gas _____ Cu. Ft.

Dry Hole _____

Abandoned _____

Date

10/17, 1917 Cordiff Scout


Map No. _____ Sec. 14 Twp. 28 R. 4

Well No. 15 Shreene Farm _____

Ohio Company _____

NORTH

WEST

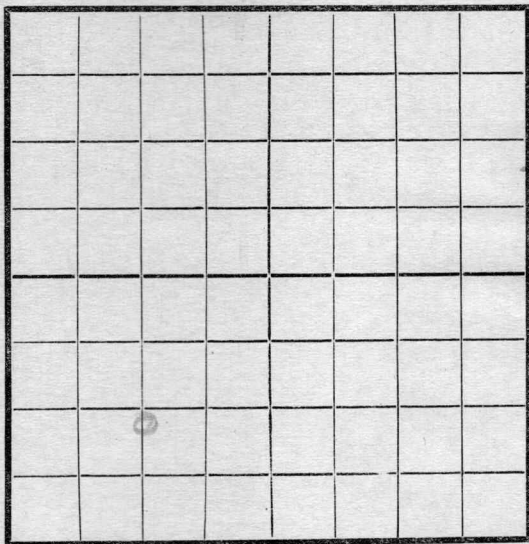

EAST

SOUTH

Location _____

Rig Up _____

Drilling and remarks

1205

RECORD

Cased _____ in. _____ Ft.

Sand _____

Gas _____

Oil _____

Total Depth _____

PRODUCTION

1st 24 hrs. Nat. _____

1st 24 hrs. after shot _____

Gas _____ Cu. Ft.

Dry Hole _____

Abandoned _____


Date

10/24/1917 Candiff Scout

Map No. _____ Sec. 14 Twp. 28 R. 4
 Well No. 15 Phoenix Farm _____
Ohio Company _____

NORTH

WEST

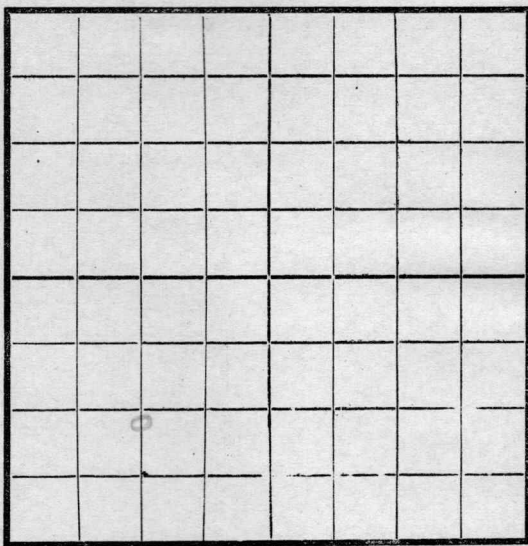

EAST

SOUTH

Location _____
 Rig Up _____
 Drilling and remarks

1730

RECORD

Cased _____ in. _____ Ft.
 Sand _____
 Gas _____
 Oil _____
 Total Depth _____

PRODUCTION

1st 24 hrs. Nat. _____
 1st 24 hrs. after shot _____
 Gas _____ Cu. Ft.
 Dry Hole _____
 Abandoned _____


Date

10/31, 1917 Candy Scout

Map No. _____ Sec. 14 Twp. 28 R. 4Well No. 15 Shreve Farm _____Oliver Company

NORTH

WEST

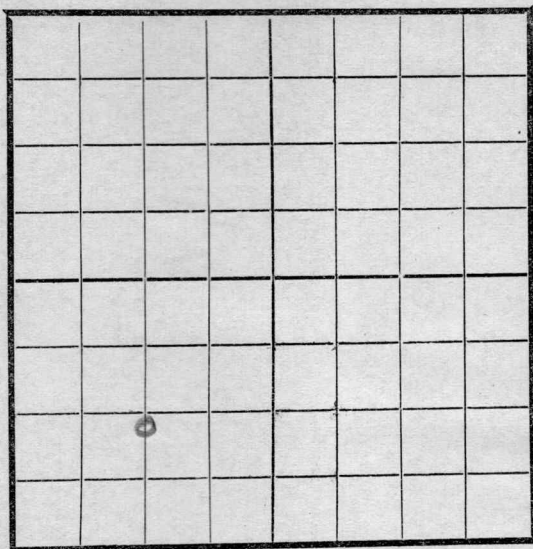

EAST

SOUTH

Location _____

Rig Up _____

Drilling and remarks

1900

RECORD

Cased _____ in. _____ Ft.

Sand _____

Gas _____

Oil _____

Total Depth _____

PRODUCTION

1st 24 hrs. Nat. _____

1st 24 hrs. after shot _____

Gas _____ Cu. Ft.

Dry Hole _____

Abandoned _____

Date

11-7-1911 Carby Scout


Map No. _____ Sec. 14 Twp. 28 R. 4Well No. 15 Shivers Farm _____

_____ Company

NORTH

WEST

EAST

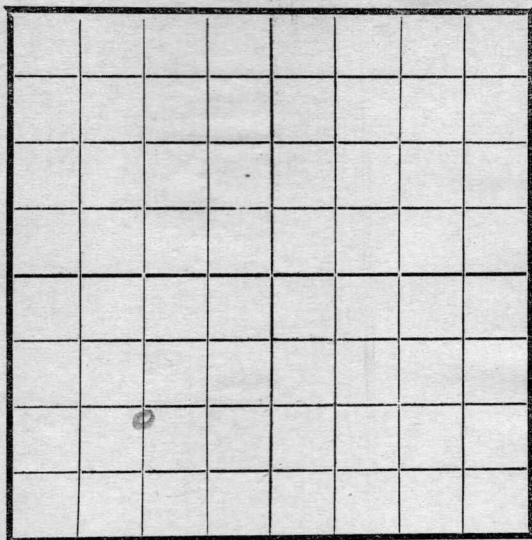

SOUTH

Location _____

Rig Up _____

Drilling and remarks

2410

RECORD

Cased _____ in. _____ Ft.

Sand _____

Gas _____

Oil _____

Total Depth _____

PRODUCTION

1st 24 hrs. Nat. _____

1st 24 hrs. after shot _____

Gas _____ Cu. Ft.

Dry Hole _____

Abandoned _____

Date

11/14, 1917 Cordiff Scout

Map No. _____ Sec. 14 Twp. 28 R. 4Well No. 15 Shivers Farm _____Company Ohio

NORTH

WEST

EAST

SOUTH

Location _____

Rig Up _____

Drilling and remarks

Key sand
2584

RECORD

Cased _____ in. _____ Ft.

Sand _____

Gas _____

Oil _____

Total Depth _____

PRODUCTION

1st 24 hrs. Nat. _____

1st 24 hrs. after shot _____

Gas _____ Cu. Ft.

Dry Hole _____

Abandoned _____


Date

11/21, 191 2 Cardiff Scout

Map No. _____ Sec. 14 Twp. 28 R. 4
 Well No. 15 Shreene Farm _____
Ohio Company _____

NORTH

WEST

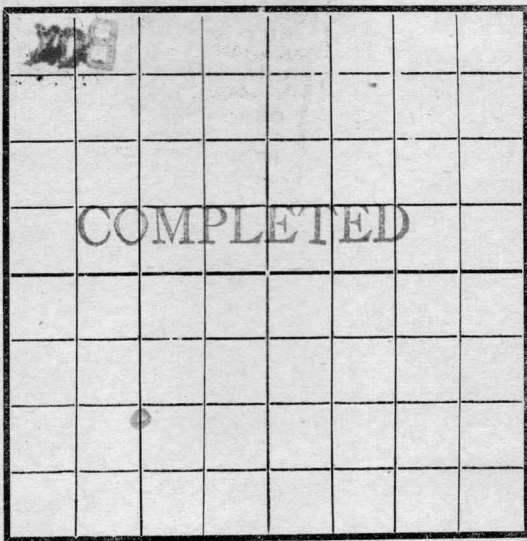

EAST

SOUTH

Location _____
 Rig Up _____
 Drilling and remarks

Est at
30 Bbls

RECORD

Cased _____ in. _____ Ft.
 Sand 2580-2586
 Gas _____
 Oil _____
 Total Depth _____

PRODUCTION

1st 24 hrs. Nat. _____
 1st 24 hrs. after shot _____
 Gas _____ Cu. Ft.
 Dry Hole _____
 Abandoned _____

Date

11/28, 1917 Canary Scout