


Map No. _____ Sec. 14 Twp. 28 R. 4
 Well No. 14 Shreve Farm _____
Ohio Company _____

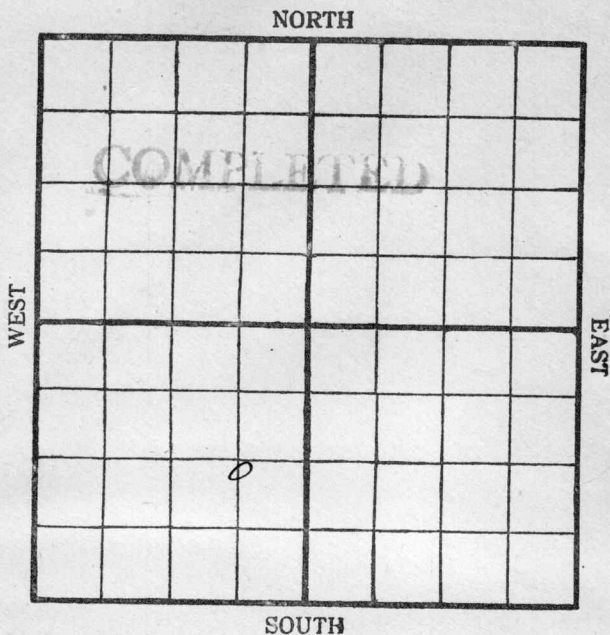

Location _____

Rig Up _____

Drilling Remarks:

Drilling Remarks:

RECORD

Cased _____ in. _____ ft.

Sand _____

Gas _____

Oil _____

Total Depth _____

PRODUCTION

1st 24 hrs. Nat. _____

1st 24 hrs. after shot _____

Gas _____ cu. ft


Dry Hole _____

Abandoned _____

Map No. _____ Sec. 14 Twp. 28 R. 4
 Well No. 141 Shreve Farm _____
Ohio Company _____

NORTH

WEST

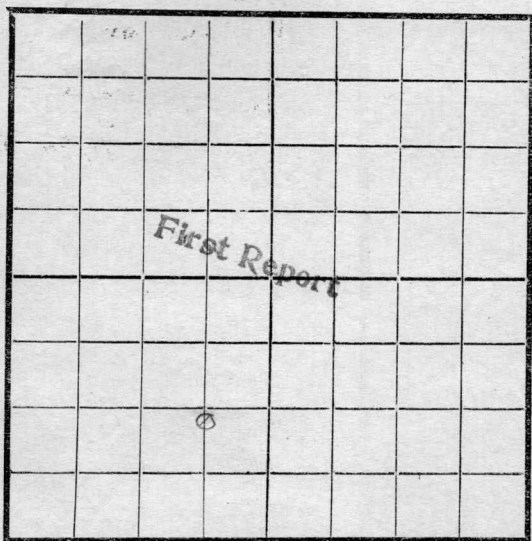

EAST

SOUTH

Location _____

Rig Up _____

Drilling and remarks

Spudding

RECORD

Cased _____ in _____ Ft

Sand _____

Gas _____

Oil _____

Total Depth _____

PRODUCTION

1st 24 hrs. Nat. _____

1st 24 hrs. after shot _____

Gas _____ Cu. Ft.

Dry Hole _____

Abandoned _____


Date

8-27-1917 Lantz Scout

Map No. _____ Sec. 14 Twp. 38 R. 4
 Well No. 14 Shreve Farm _____
Oliver Company _____

NORTH

WEST

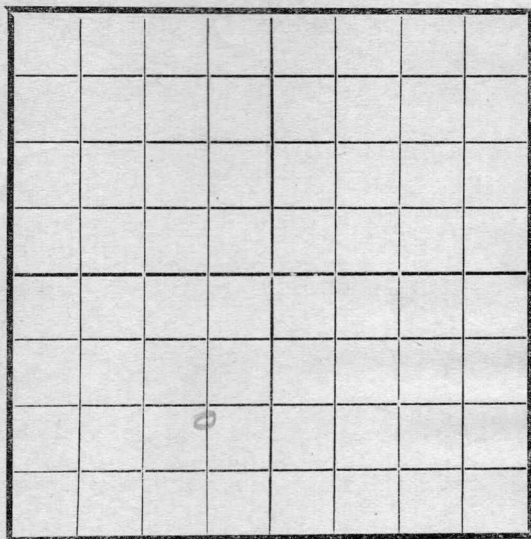

EAST

SOUTH

RECORD

Location _____

Cased _____ in. _____ Ft.

Rig Up _____

Sand _____

Drilling and remarks

Gas _____

Oil _____

Total Depth _____

PRODUCTION

1st 24 hrs. Nat. _____

1st 24 hrs. after shot _____

Gas _____ Cu. Ft.

Dry Hole _____

Abandoned _____


Date

10/9, 1917 C. C. Cuddy Scout _____

Map No. _____ Sec. 14 Twp. 28 R. 4
 Well No. 14 Shreene Farm _____
Ohio Company _____

NORTH

WEST

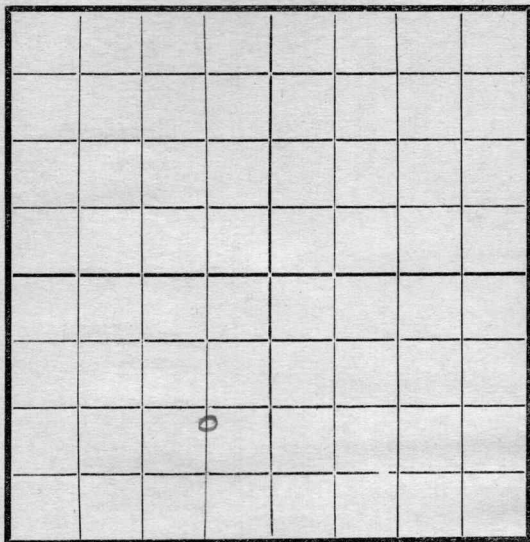

EAST

SOUTH

Location _____

Rig Up _____

Drilling and remarks

Shut Down
2000

RECORD

Cased _____ in. _____ Ft.

Sand _____

Gas _____

Oil _____

Total Depth _____

PRODUCTION

1st 24 hrs. Nat. _____

1st 24 hrs. after shot _____

Gas _____ Cu. Ft.


Dry Hole _____

Abandoned _____

Date

10/17, 1917 Condyff Scout

Map No. _____ Sec. 14 Twp. 28 R. 4
Well No. 14 Shreve Farm _____
Olin Company _____

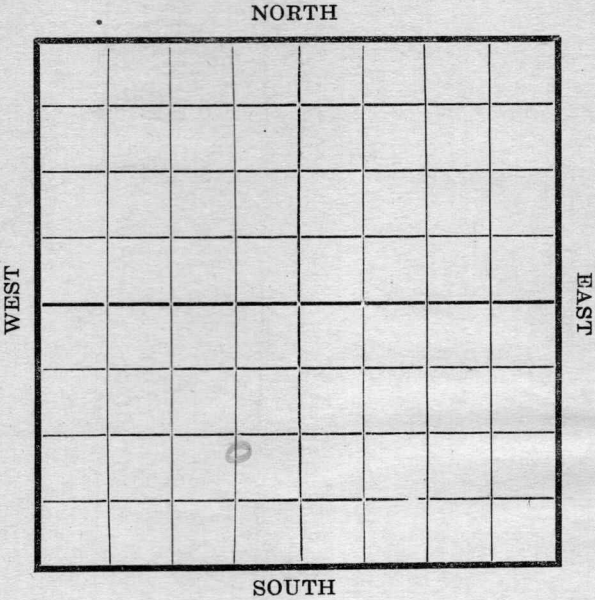


Location _____ Rig Up _____ Drilling and remarks _____ <u>2590</u>	RECORD
	Cased _____ in. _____ Ft.
	Sand _____
	Gas _____
	Oil _____
	Total Depth _____
	PRODUCTION
	1st 24 hrs. Nat. _____
	1st 24 hrs. after shot _____
	Gas _____ Cu. Ft.
	Dry Hole _____
	Abandoned _____

Date _____
10/24, 1917 C. C. C. Scout _____

Map No. _____ Sec. 14 Twp. 28 R. 4
 Well No. 14 Shreene Farm _____
Oliver Company _____

NORTH

WEST

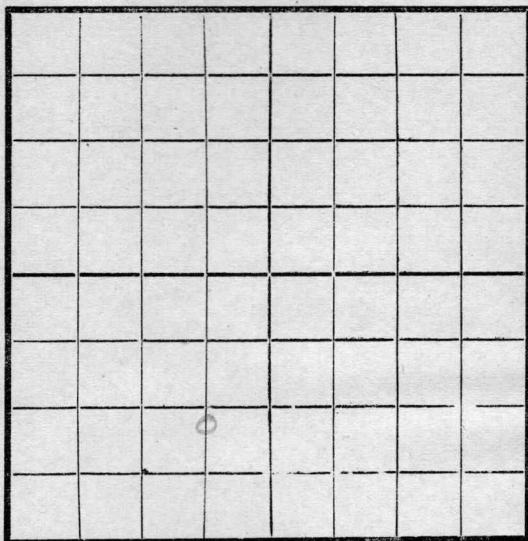

EAST

SOUTH

Location _____
 Rig Up _____
 Drilling and remarks _____

Top Sand
2577

RECORD

Cased _____ in. _____ Ft.
 Sand _____
 Gas _____
 Oil _____
 Total Depth _____

PRODUCTION

1st 24 hrs. Nat. _____
 1st 24 hrs. after shot _____
 Gas _____ Cu. Ft.
 Dry Hole _____
 Abandoned _____


Date

10/31, 1911 Canby Scout

Map No. _____ Sec. 14 Twp. 28 R. 4
 Well No. 14 Shreene Farm _____
Ohio Company _____

NORTH

WEST

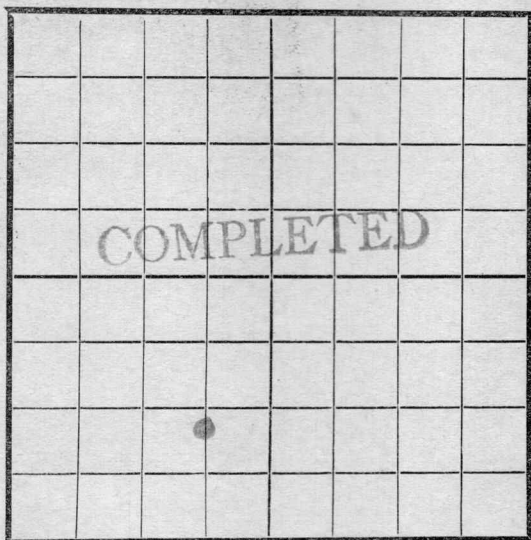

EAST

SOUTH

RECORD

Location _____

Cased _____ in _____ Ft.

Rig Up _____

Sand 2527-2588

Drilling and remarks

Gas _____

Oil _____

Total Depth _____

Est at
200
Barrel

PRODUCTION

1st 24 hrs. Nat. _____

1st 24 hrs. after shot _____

Gas _____ Cu. Ft.

Dry Hole _____

Abandoned _____

Date

11-7, 1917 Candis Scout