

Map No. _____ Sec. 15 Twp. 27 R. 4Well No. 5 Loomis Farm
Carter Company

NORTH

WEST

EAST

SOUTH

Location _____

Rig Up 10/30/16

Drilling Remarks:

Drilling Remarks:

221 = 11/9-11/14-11/27225 = 12/4560' = 12/111035' = 12/181300 = 12/281765 = 1/8/171875 = 1/15

RECORD

PRODUCTION

Cased _____ in _____ Ft.

1st 24 hrs. Nat. _____

Sand _____

1st 24 hrs. after shot _____

Gas _____

Gas _____ Cu. Ft.

Oil _____

Dry Hole _____


Total Depth _____

Abandoned _____

Map No. _____ Sec. 15 Twp. 27 R. 4

Well No. 5 Loomis Farm

Carter Company

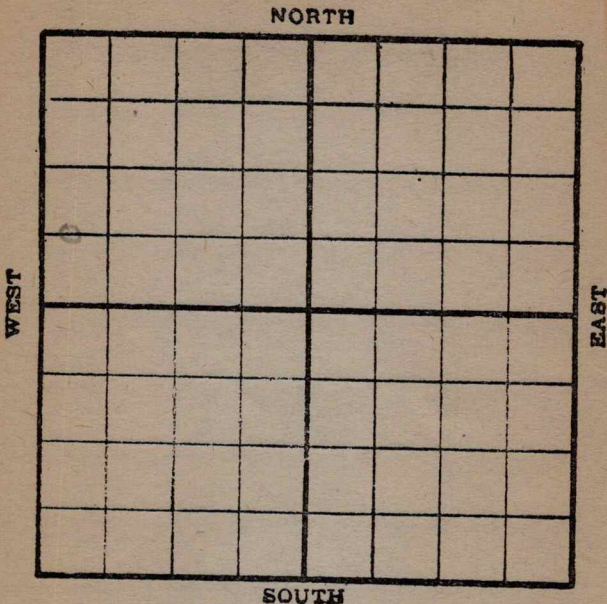

Location _____

Rig up ☒ _____

Drilling and remarks:

RECORD

Cased _____ in. _____ Ft.

Sand _____

Gas _____

Oil _____

Total Depth _____

PRODUCTION

1st. 24 hrs. Nat. _____

1st. 24 hrs. after shot _____

Gas _____ Cu. Ft.

Dry Hole _____

Abandoned _____


Date

10/30, 1916, Scout

Map No. _____ Sec. 15 Twp. 27 R. 4Well No. 5 Loomis FarmCarter Company

NORTH

WEST

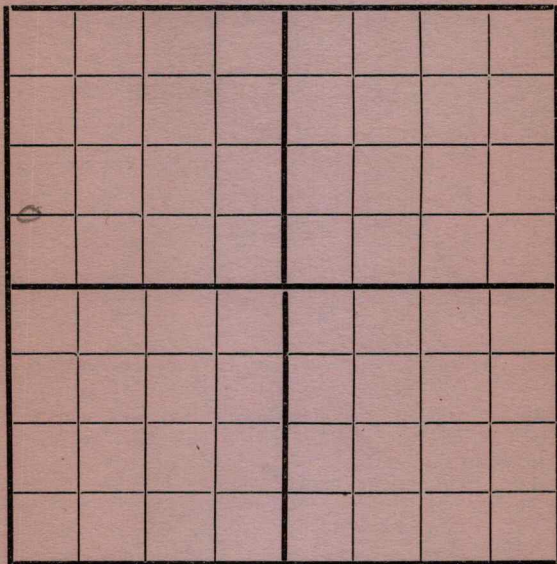

EAST

SOUTH

Location _____

Rig Up ☒ _____

Drilling and remarks _____

RECORD

Cased _____ in. _____ Ft.

Sand _____

Gas _____

Oil _____

Total Depth _____

PRODUCTION

1st 24 hrs. Nat. _____

1st 24 hrs. after shot _____

Gas _____ Cu. Ft.

Dry Hole _____


Abandoned _____

Date

11/9, 1916 Alley Scout

Map No. _____ Sec. 15 Twp. 27 R. 4
 Well No. 5 Farm _____
 _____ Company

NORTH

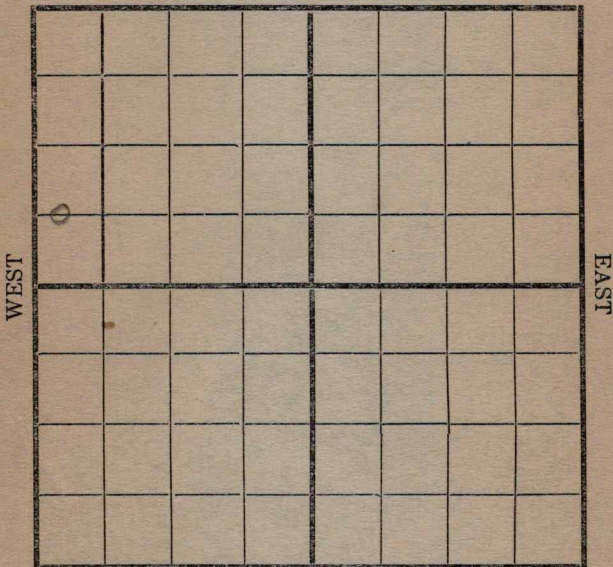

SOUTH

Location _____
 Rig Up ☒ _____
 Drilling and remarks _____

RECORD

Cased _____ in. _____ Ft.
 Sand _____
 Gas _____
 Oil _____
 Total Depth _____

PRODUCTION

1st 24 hrs. Nat. _____
 1st 24 hrs. after shot _____
 Gas _____ Cu. Ft.
 Dry Hole _____
 Abandoned _____

Date

11/14 1916 Carroll Scout

Map No. _____ Sec. 15 Twp. 22 R. 4Well No. 5200 Farm _____

_____ Company _____

NORTH

WEST

EAST

SOUTH

Location _____

Rig Up _____

Drilling and remarks _____

RECORD

Cased _____ in. _____ Ft.

Sand _____

Gas _____

Oil _____

Total Depth _____

PRODUCTION

1st 24 hrs. Nat. _____

1st 24 hrs. after shot _____

Gas _____ Cu. Ft.

Dry Hole _____

Abandoned _____

Date


11/20, 1916 Cordell Scout

Map No. _____ Sec. 15 Twp. 27 R. 4
 Well No. 5 Loomis Farm _____
Carter Company _____

NORTH

WEST

EAST

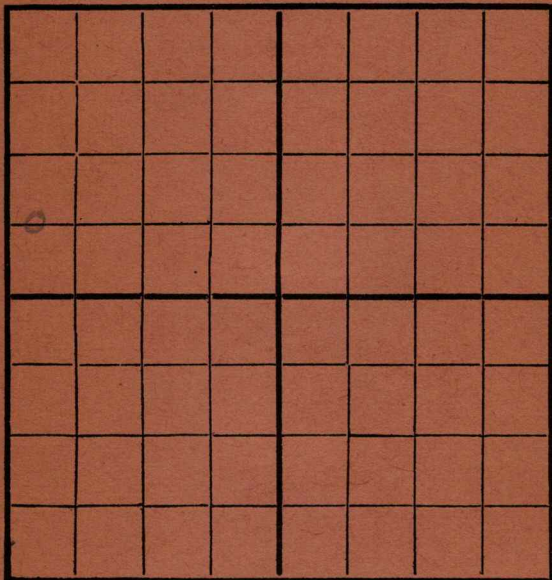

SOUTH

Location _____
 Rig Up _____
 Drilling and remarks _____

Rigging up

RECORD

Cased _____ in. _____ Ft.
 Sand _____
 Gas _____
 Oil _____
 Total Depth _____

PRODUCTION

1st 24 hrs. Nat. _____
 1st 24 hrs. after shot _____
 Gas _____ Cu. Ft.
 Dry Hole _____
 Abandoned _____

Date


11/27, 1916 C. Carter Scout

Map No. _____ Sec. 15 Twp. 27 R. 4Well No. 5 Loomis Farm _____
Carter Company _____

NORTH

WEST

EAST

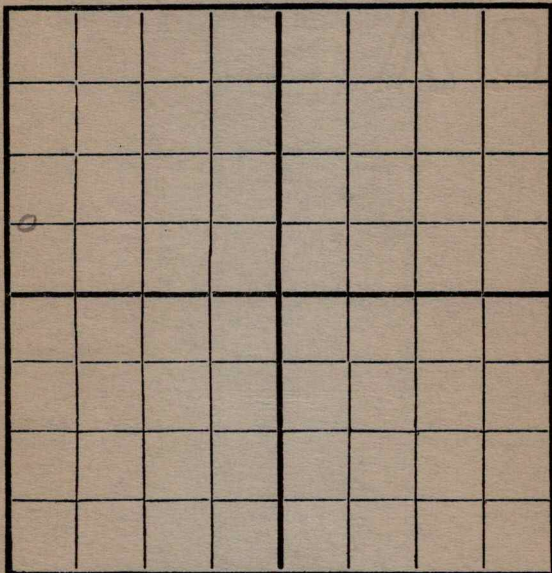

SOUTH

Location _____

Rig Up _____

Drilling and remarks

225

RECORD

Cased _____ in. _____ Ft.

Sand _____

Gas _____

Oil _____

Total Depth _____

PRODUCTION

1st 24 hrs. Nat. _____

1st 24 hrs. after shot _____

Gas _____ Cu. Ft.

Dry Hole _____

Abandoned _____

Date

12/4, 1916, Carter Scout

Map No. _____ Sec. 15 Twp. 27 R. 4Well No. 5 Loomis Farm
Robert Company

NORTH

WEST

EAST

SOUTH

RECORD

Location _____ Cased _____ in _____ Ft.

Rig Up _____ Sand _____

Drilling and remarks _____ Gas _____

Oil _____

Total Depth _____

PRODUCTION

1st 24 hrs. Nat. _____

1st 24 hrs. after shot _____

Gas _____ Cu. Ft.

Dry Hole _____

Abandoned _____

Date


12/11, 1916, Condy Scout

Map No. _____ Sec. 15 Twp. 27 R. 4
 Well No. 5 Loomis Farm _____
Carter Company _____

NORTH

WEST

EAST

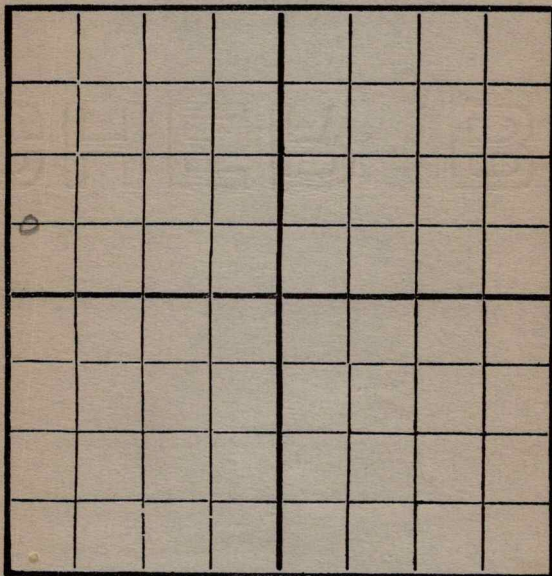

SOUTH

Location _____
 Rig Up _____
 Drilling and remarks _____

1035'

RECORD


Cased _____ in. _____ Ft.
 Sand _____
 Gas _____
 Oil _____
 Total Depth _____

PRODUCTION

1st 24 hrs. Nat. _____
 1st 24 hrs. after shot _____
 Gas _____ Cu. Ft.
 Dry Hole _____
 Abandoned _____

Date 12/18/16 C. Carter Scout _____

Map No. _____ Sec. 15 Twp. 27 R. 4
 Well No. 5 Loomis Farm
Carter Company

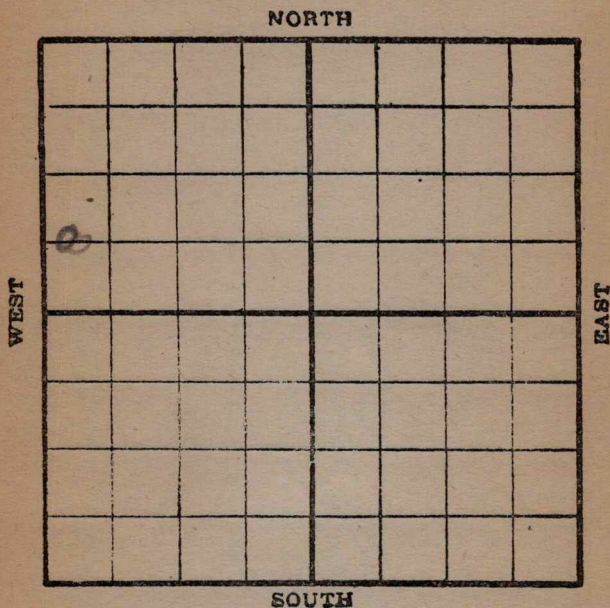

Location _____
 Rig up _____
 Drilling and remarks:

1300'

RECORD

Cased _____ in. _____ Ft.
 Sand _____
 Gas _____
 Oil _____
 Total Depth _____

PRODUCTION

1st. 24 hrs. Nat. _____
 1st. 24 hrs. after shot _____
 Gas _____ Cu. Ft.
 Dry Hole _____
 Abandoned _____

Date

10/28, 1916 Carter Scout

Map No. _____ Sec. 15 Twp. 27 R. 4
Well No. 5 Loomis Farm _____
Carter Company _____

NORTH

WEST

EAST

SOUTH

Location _____
Rig Up _____
Drilling and remarks _____

RECORD

Cased _____ in. _____ Ft.
 Sand _____
 Gas _____
 Oil _____
 Total Depth _____

PRODUCTION

1st 24 hrs. Nat. _____
1st 24 hrs. after shot _____
Gas _____ Cu. Ft. _____
Dry Hole _____
Abandoned _____

Date _____


Date 1/17 1917 Carleton Scout

Map No. _____ Sec. 15 Twp. 27 R. 4
 Well No. 5 Farm _____
Center Company _____

NORTH

WEST

EAST

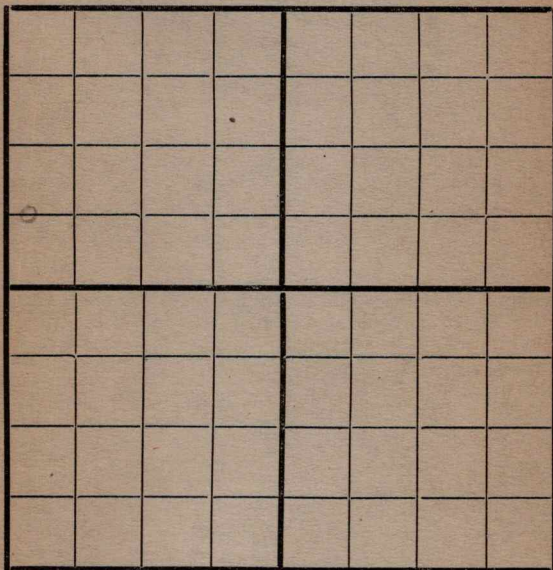

SOUTH

Location _____
 Rig Up _____
 Drilling and remarks _____

RECORD

Cased _____ in. _____ Ft.
 Sand _____
 Gas _____
 Oil _____
 Total Depth _____

PRODUCTION

1st 24 hrs. Nat. _____
 1st 24 hrs. after shot _____
 Gas _____ Cu. Ft.
 Dry Hole _____
 Abandoned _____

Date


1/8, 1917 Center Scout

Map No. _____ Sec. 15 Twp. 22 R. 4
 Well No. 5200 Farm _____
Carter Company _____

NORTH

WEST

EAST

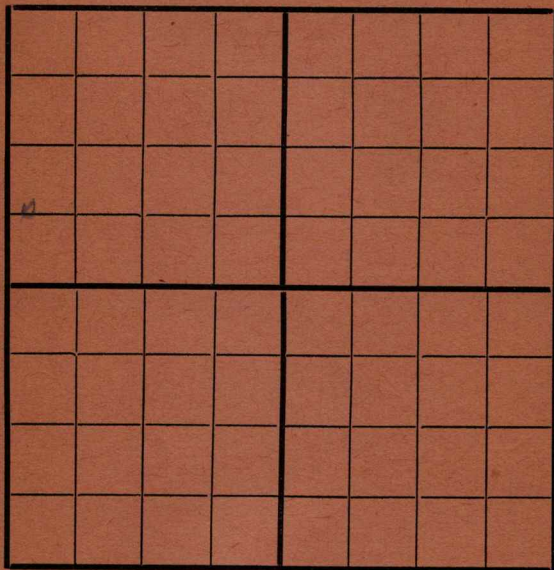

SOUTH

Location _____
 Rig Up _____
 Drilling and remarks _____

RECORD

Cased _____ in. _____ Ft.
 Sand _____
 Gas _____
 Oil _____
 Total Depth _____

PRODUCTION

1st 24 hrs. Nat. _____
 1st 24 hrs. after shot _____
 Gas _____ Cu. Ft.
 Dry Hole _____
 Abandoned _____

Date

1/15, 1917 Carter Scout

Map No. _____ Sec. 15 Twp. 27 R. 4
Carter Company

NORTH

WEST

EAST

SOUTH

Location _____
 Rig Up _____
 Drilling and remarks

2260'

RECORD

Cased _____ in. _____ Ft.
 Sand _____
 Gas _____
 Oil _____
 Total Depth _____

PRODUCTION

1st 24 hrs. Nat. _____
 1st 24 hrs. after shot _____
 Gas _____ Cu. Ft.
 Dry Hole _____
 Abandoned _____

Date


1/23 191 7 Carter Scout

Map No. _____ Sec. 15 Twp. 27 R. 4
 Well No. 5 Loomis _____ Farm
Carter _____ Company

NORTH

WEST

EAST

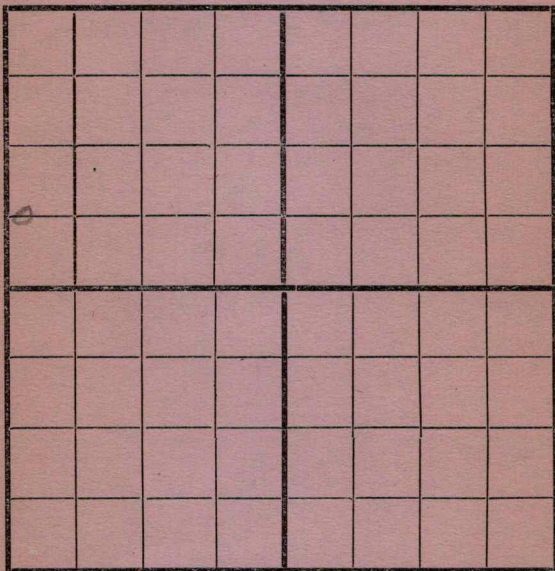

SOUTH

Location _____

Rig Up _____

Drilling and remarks

2320'

RECORD

Cased _____ in. _____ Ft.

Sand _____

Gas _____

Oil _____

Total Depth _____

PRODUCTION

1st 24 hrs. Nat. _____

1st 24 hrs. after shot _____

Gas _____ Cu. Ft.

Dry Hole _____

Abandoned _____


Date

1/29, 1917

Carter Scout

Map No. _____ Sec. 15 Twp. 27 R. 4
 Well No. 5 Loomis _____ Farm
Carter _____ Company

NORTH

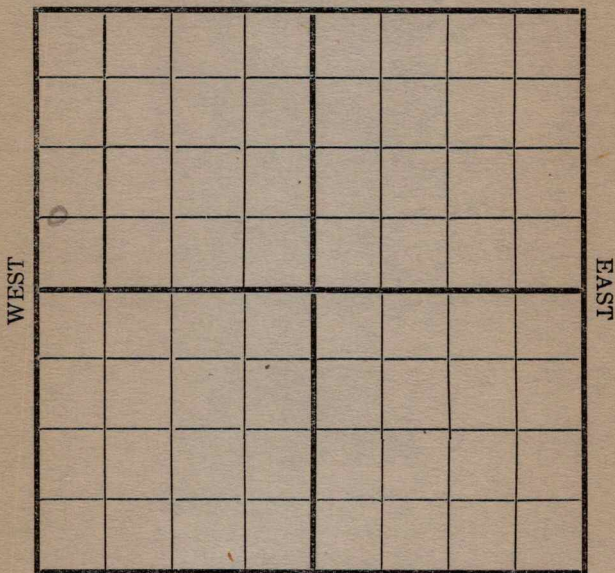

SOUTH

Location _____
 Rig Up _____
 Drilling and remarks _____

RECORD

Cased _____ in. _____ Ft.
 Sand _____
 Gas _____
 Oil _____
 Total Depth _____

PRODUCTION

1st 24 hrs. Nat. _____
 1st 24 hrs. after shot _____
 Gas _____ Cu. Ft.
 Dry Hole _____
 Abandoned _____

Date


2/5, 191 7 Carter Scout

Map No. _____ Sec. 15 Twp. 27 R. 4
 Well No. 5 Loomis Farm
Carter Company

NORTH

WEST

EAST

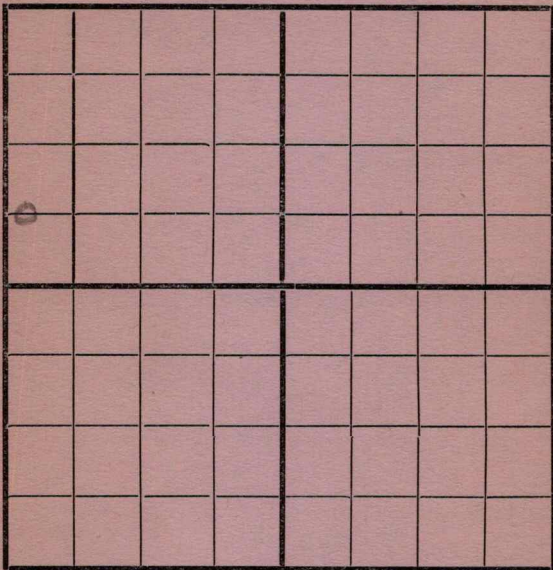

SOUTH

Location _____
 Rig Up _____
 Drilling and remarks _____

Top sand
2452'
Drilling 2517
1400' oil in
hole

RECORD

Cased _____ in. _____ Ft.
 Sand _____
 Gas _____
 Oil _____
 Total Depth _____

PRODUCTION


1st 24 hrs. Nat. _____
 1st 24 hrs. after shot _____
 Gas _____ Cu. Ft.
 Dry Hole _____
 Abandoned _____

Date 01/15 1917 Carter Scout

Map No. _____ Sec. 15 Twp. 27 R. 4
 Well No. 5 Loomis Farm _____
Carter Company _____

NORTH

WEST

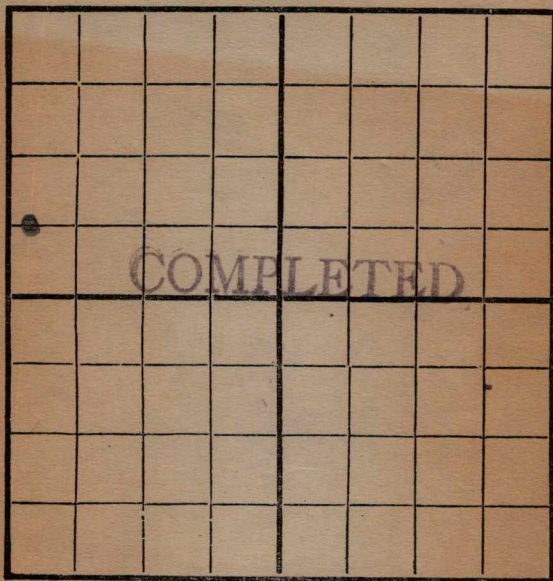

EAST

SOUTH

Location _____

Rig Up _____

Drilling and remarks

*Estimated
good for.
150 Bbls*

RECORD

Cased _____ in. _____ Ft.

Sand 2452-2518

Gas _____

Oil _____

Total Depth _____

PRODUCTION

1st 24 hrs. Nat. _____

First 24 hrs. after shot _____

Gas _____ Cu. Ft.

Dry Hole _____

Abandoned _____

Date

2/19 191 7 Candiff Scout