


Map No. _____ Sec. 16 Twp. 28 R. 4

Well No. 5 Brown Farm

Brown & Shaver Company

NORTH

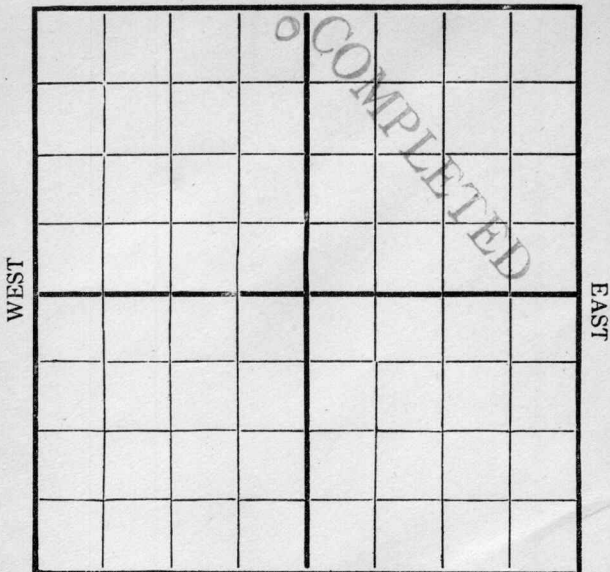

SOUTH

Location _____

Drilling Remarks:

300.

Rig Up _____

Drilling Remarks:

RECORD

Cased _____ in _____ Ft.

Sand _____

Gas _____

Oil _____

Total Depth _____

PRODUCTION

1st 24 hrs. Nat. _____

1st 24 hrs. after shot _____

Gas _____ Cu. Ft.

Dry Hole _____


Abandoned _____

Map No. _____ Sec. 13 Twp. 28 R. 2Well No. 5 W E Brown Farm __________Brown & Shaver Company

NORTH

WEST

EAST

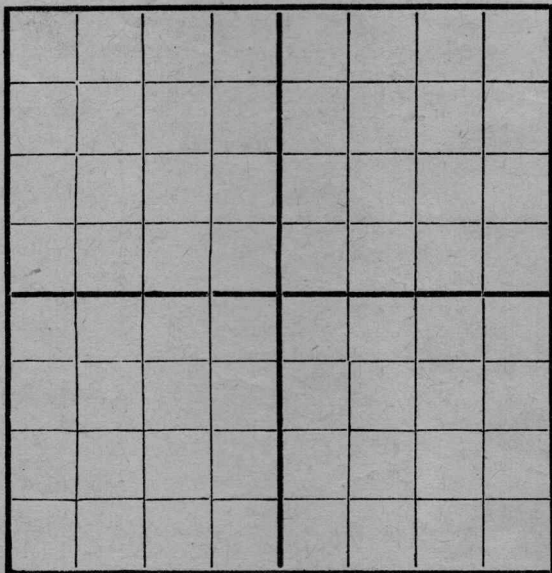

SOUTH

Location _____

Rig Up ☒ _____

Drilling and remarks _____

RECORD

Cased _____ in. _____ Ft.

Sand _____

Gas _____

Oil _____

Total Depth _____

PRODUCTION

1st 24 hrs. Nat. _____

1st 24 hrs. after shot _____

Gas _____ Cu. Ft.

Dry Hole _____

Abandoned _____

Date

7/3, 1916 Wendy Scout


Map No. _____ Sec. 15 Twp. 28 R. 4

Well No. 5 Brown Farm _____

Brown & Shamba Company _____

NORTH

WEST

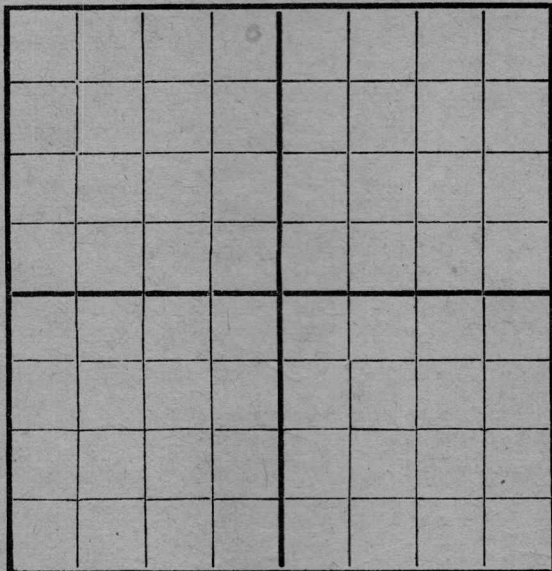

EAST

SOUTH

Location _____

Rig Up _____

Drilling and remarks

300'

RECORD

Cased _____ in. _____ Ft.

Sand _____

Gas _____

Oil _____

Total Depth _____

PRODUCTION

1st 24 hrs. Nat. _____

1st 24 hrs. after shot _____

Gas _____ Cu. Ft.

Dry Hole _____

Abandoned _____


Date

7/18, 1916 Scout

Map No. _____ Sec. 15 Twp. 28 R. 4
 Well No. 5 Brown Farm
Brown & Shuman Company

NORTH

WEST

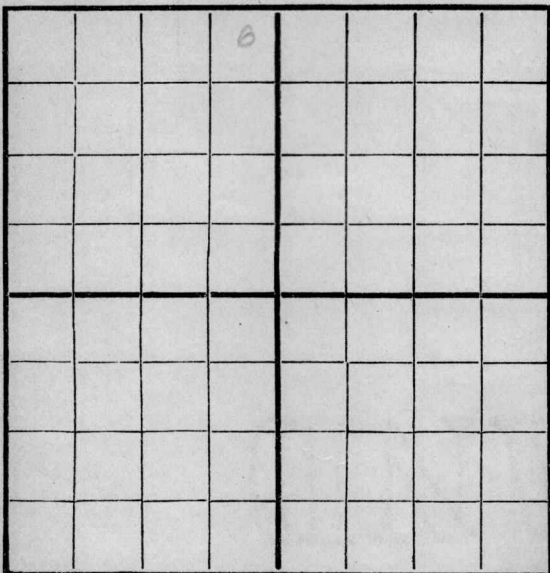

EAST

SOUTH

Location _____
 Rig Up _____
 Drilling and remarks

850'

RECORD

Cased _____ in. _____ Ft.
 Sand _____
 Gas _____
 Oil _____
 Total Depth _____

PRODUCTION


1st 24 hrs. Nat. _____
 1st 24 hrs. after shot _____
 Gas _____ Cu. Ft.
 Dry Hole _____
 Abandoned _____

Date

7/31, 1916 Scout Scout

Map No. _____ Sec. 15 Twp. 28 R. 4
Well No. 5 Brown Farm _____
Brown & Co. Company

NORTH

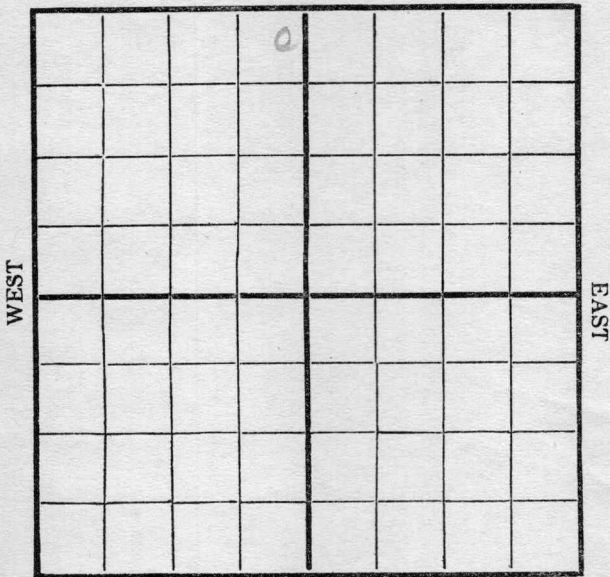

SOUTH

Location _____
Rig Up _____
Drilling and remarks

1450

RECORD

Cased _____ in. _____ Ft.
Sand _____
Gas _____
Oil _____
Total Depth _____

PRODUCTION


1st 24 hrs. Nat. _____
1st 24 hrs. after shot _____
Gas _____ Cu. Ft.
Dry Hole _____
Abandoned _____

Date 8/8, 1916 B. Brown & Co. Scout

Map No. _____ Sec. 15 Twp. 28 R. 4
 Well No. 5 Brown Farm _____
Brown & Shaver Company _____

NORTH

WEST

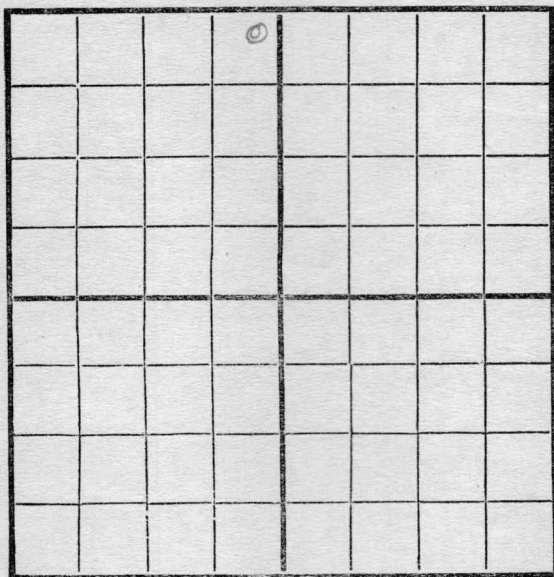

EAST

SOUTH

Location _____
 Rig Up _____
 Drilling and remarks

1850

RECORD

Cased _____ in. _____ Ft.
 Sand _____
 Gas _____
 Oil _____
 Total Depth _____

PRODUCTION

1st 24 hrs. Nat. _____
 First 24 hrs. after shot _____
 Gas _____ Cu. Ft.
 Dry Hole _____
 Abandoned _____

Date

8/14


1916

Randy

Scout

Map No. _____ Sec. 15 Twp. 28 R. 4
 Well No. 5 Brown Farm _____
 _____ Brown & Gibson Company

NORTH

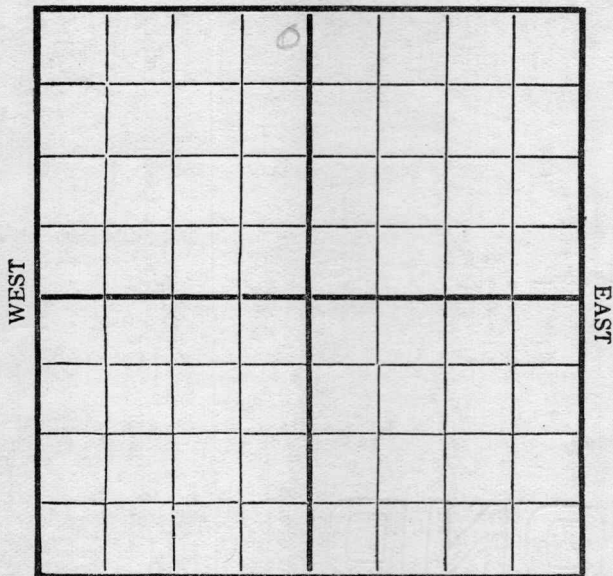

SOUTH

Location _____
 Rig Up _____
 Drilling and remarks _____

1994- Cocek
6 5/8"

RECORD

Cased _____ in. _____ Ft.
 Sand _____
 Gas _____
 Oil _____
 Total Depth _____


PRODUCTION

1st 24 hrs. Nat. _____
 First 24 h. s. after shot _____
 Gas _____ Cu. Ft.
 Dry Hole _____
 Abandoned _____

Date 8/21, 191 6 Barclay Scout

Map No. _____ Sec. 15 Twp. 28 R. 4
Well No. 5 Brown Farm
Brown & Shaver Company

NORTH

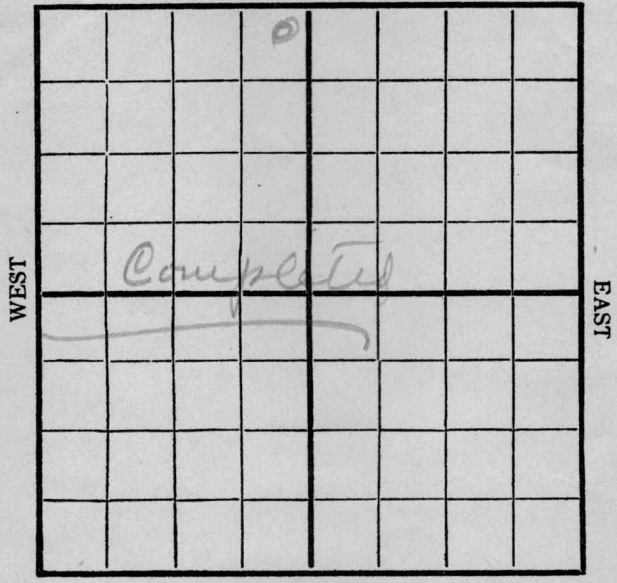

SOUTH

	RECORD
Location _____	Cased _____ in. _____ Ft.
Rig Up _____	Sand <u>2060-2074</u>
Drilling and remarks	Gas _____
<u>2060-2074</u>	Oil _____
<u>Good for 175</u>	Total Depth _____
<u>bls in</u>	
<u>shallow sand</u>	

PRODUCTION	
1st 24 hrs. Nat. _____	
1st 24 hrs. after shot _____	
Gas _____	Cu. Ft.
Dry Hole _____	
Abandoned _____	

Date Aug 30, 1916 LLC Scout