

Section 15 Township 27 Range 4E


Well No. #16 Loomis

Company Molk Petroleum

NORTH

WEST

EAST

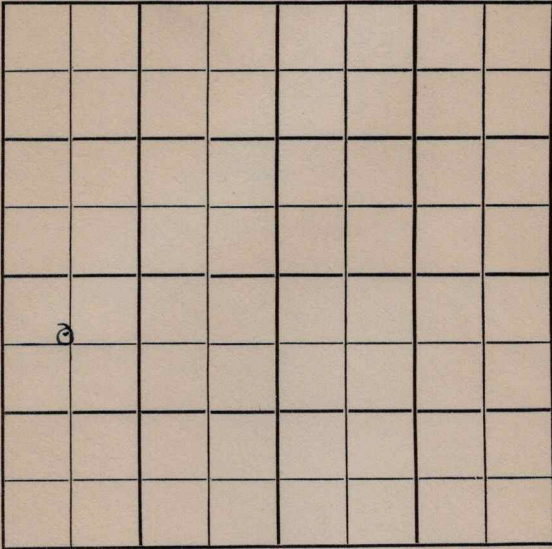

SOUTH

12

Sec. 15 Twp. 27 R.

Well No. #16 Loomis Farm

Molk Petroleum Company

Molk Pet. - Contr. Contractor


Ft. from N. Line

2040' Ft. from S. Line

Ft. from E. Line

620' Ft. from W. Line

C NW SW

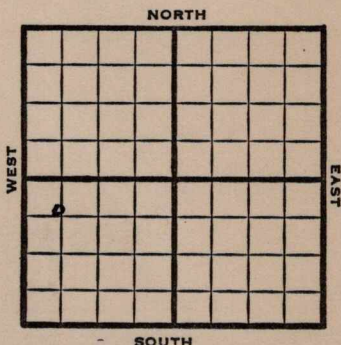

1950

Elev. 1252'

REPORT

10/31

Spud 10-31-50

12" @ 695'

10" @ 1412'

Drlg. 1700'

12/20

12" @ 695'

10" @ 1412'

Lans 1735

KC 2055

Pay 2565

TD 2571

7" @ 2563

10 qt/2571 DD 2573

D&A TD 2573'

ABANDONED

County Butler State KansasSec. 15 (Blk.) 27 (Sur.) 4E Map No.Operator Molk PetroleumWell No. 16 Farm LoomisElev. 1252 Location C ~~SE~~ NW SW

OX

FIRST REPORT

2040
500 Ft. From S Line SW620
500 Ft. From W Line Quarter

NOV 15 1950

1st. Report

Completion

Remarks

Molk Pet. - Contr.Spudding Date 10-31-50

Drlg. Data

12" @ 695 10" @ 1412 drlg. 1700

J. E. TYRA

761566

Please check ~~XXXXXXXXXXXXXXXXXXXX~~
How can you put this well in the
C E Line NW SW ~~an~~ using these feet
measurements

Advise
Sam

Note: Please measure all wells from
~~quarter~~ quarter lines.

NOV 29 1950

Scout Cards *OK*
Land Small Map
Land Wall Map *35*
Trailings
France Map
Pierce Map
Misc.


Drig. Data

Kansas

Map No. _____ Sec. 15 Twp. 27 R. 4EWell No. 16 LoomisMolk Petroleum Company**CORRECTION**_____
Contractor

C NW SW

SECTION PLAT

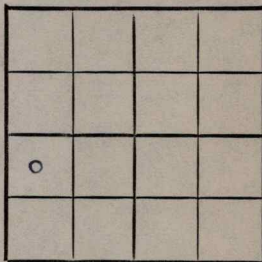Ft. from N. Line2040 Ft. from S. Line_____
Ft. from E. Line620 Ft. from W. LineButler County

Location _____

Rig up _____

Drilling and Remarks:

Reported

C E L NW SW

500 from S line

500 from W line

RECORD

Cased _____ in., _____ ft.

Sand _____

Gas _____

Oil _____

Total Depth _____

PRODUCTION

1st 24 hrs. Nat. _____

1st 24 hrs. after shot _____

Gas _____ Cu. Ft.

Dry Hole _____

Abandoned _____

Date

NOV 22 1950 19J. E. TYRA

Scout

County Butler State KansasSec. 15 (Blk.
Twps.) 27 (Sur.
Rge.) 4E Map No.Operator Molk PetroleumWell No. 16 Farm LoomisElev. 1252 Location C NW SW2040 Ft. From S Line SW620 Ft. From W Line Quarter

1st. Report

Completion DEC 20 1950

Remarks

Molk Pet. - Contr.Spudding Date 10-31-50Drilg. Data D & A TD 257312" @ 695 10" @ 1412 Lans. 1735KC 2055 Pay 2565 TD 2571 7" @ 256310 qt/ 2571 DD 2573D & A

J. E. TYRA