


Map No. _____ Sec. 15 Twp. 28 R. 4

Well No. 6 Brown Farm

Brown & Co. Company

NORTH

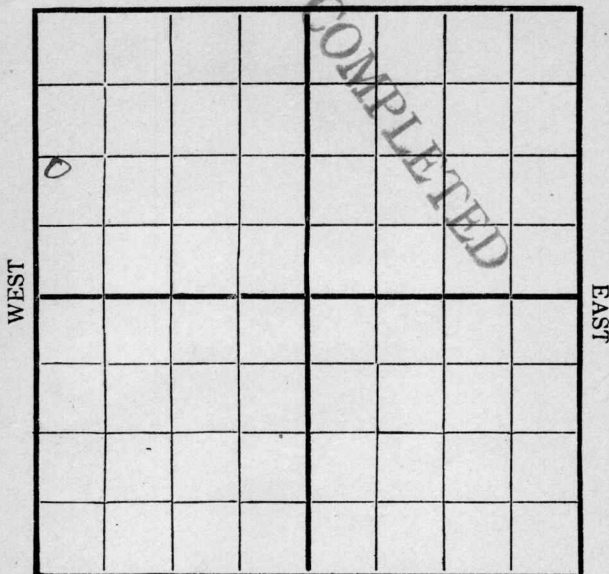

SOUTH

Location _____

Rig Up _____

Drilling Remarks:

Drilling Remarks:

8/8 Spudding
10/2-2260

RECORD

Cased _____ in. _____ Ft.

Sand _____

Gas _____

Oil _____

Total Depth _____

PRODUCTION

1st 24 hrs. Nat. _____

1st 24 hrs. after shot _____

Gas _____ Cu. Ft.

Dry Hole _____


Abandoned _____

Map No. _____ Sec. 15 Twp. 28 R. 4

Well No. 6 _____ Farm _____

Brown & Shum Company

NORTH

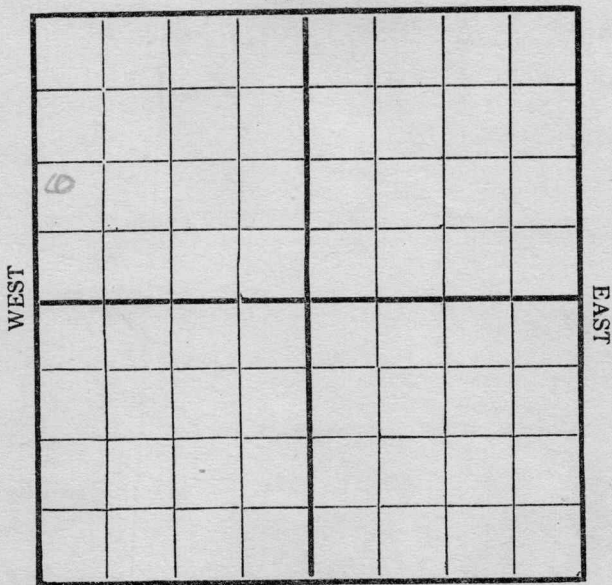

SOUTH

Location _____

Rig Up _____

Drilling and remarks

Spudding

RECORD

Cased _____ in. _____ Ft.

Sand _____

Gas _____

Oil _____

Total Depth _____

PRODUCTION

1st 24 hrs. Nat. _____

1st 24 hrs. after shot. _____

Gas _____ Cu. Ft.

Dry Hole _____

Abandoned _____

Date

8/8, 1916 Alameda Scout

Map No. _____ Sec. 15 Twp. 28 R. 4Well No. 6 Brown Farm
Brown & Shuman Company

NORTH

WEST

EAST

SOUTH

Location _____

Rig Up _____

Drilling and remarks

Bad HoleProbably have
to start
a new
one

RECORD

Cased _____ in. _____ Ft.

Sand _____

Gas _____

Oil _____

Total Depth _____

PRODUCTION

1st 24 hrs. Nat. _____

First 24 hrs. after shot _____

Gas _____ Cu. Ft.

Dry Hole _____

Abandoned _____

Date


8/14, 1916 Scout

Map No. _____ Sec. 15 Twp. 28 R. 4
 Well No. 6 Brown Farm _____
Brown & Shuman Company

NORTH

WEST

EAST

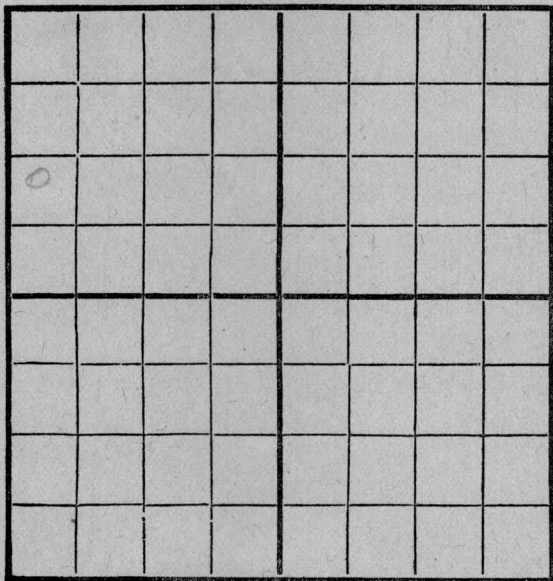

SOUTH

Location _____
 Rig Up _____
 Drilling and remarks

400'

RECORD

Cased _____ in. _____ Ft.
 Sand _____
 Gas _____
 Oil _____
 Total Depth _____

PRODUCTION


1st 24 hrs. Nat. _____
 First 24 h. s. after shot _____
 Gas _____ Cu. Ft.
 Dry Hole _____
 Abandoned _____

Date 8/21, 1916 Alley Scout

Map No. _____ Sec. 15 Twp. 38 R. 4
 Well No. 16 Brown Farm _____
Brown & Shaver Company _____

NORTH

WEST

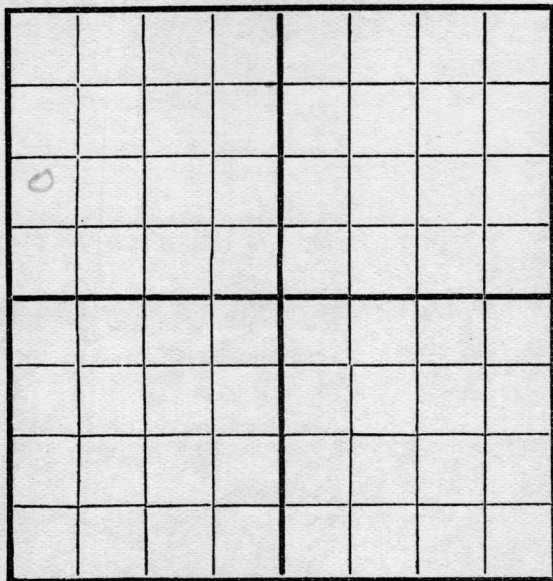

EAST

SOUTH

Location _____

Rig Up _____

Drilling and remarks

825

RECORD

Cased _____ in. _____ Ft.

Sand _____

Gas _____

Oil _____

Total Depth _____

PRODUCTION

1st 24 hrs. Nat. _____

1st 24 hrs. after shot _____

Gas _____ Cu. Ft.

Dry Hole _____

Abandoned _____

Date

191


Scout

AUG 30 1916

L. A. Shaver

Map No. _____ Sec. 15 Twp. 28 R. 4Well No. 6 Brown Farm
Brown & Shaver Company

NORTH

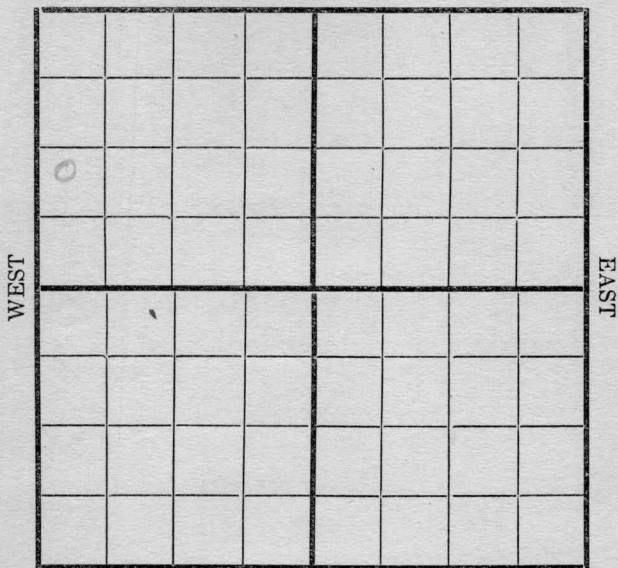

WEST

EAST

SOUTH

Location _____

Rig Up _____

Drilling and remarks

1210

RECORD

Cased _____ in. _____ Ft.

Sand _____

Gas _____

Oil _____

Total Depth _____

PRODUCTION

1st 24 hrs. Nat. _____

1st 24 hrs. after shot _____

Gas _____ Cu. Ft.

Dry Hole _____

Abandoned _____

Date

9/5, 1916 L. D. Conley Scout


Map No. _____ Sec. 15 Twp. 28 R. 4

Well No. 6 Brown Farm _____

Monitor Company _____

NORTH

WEST

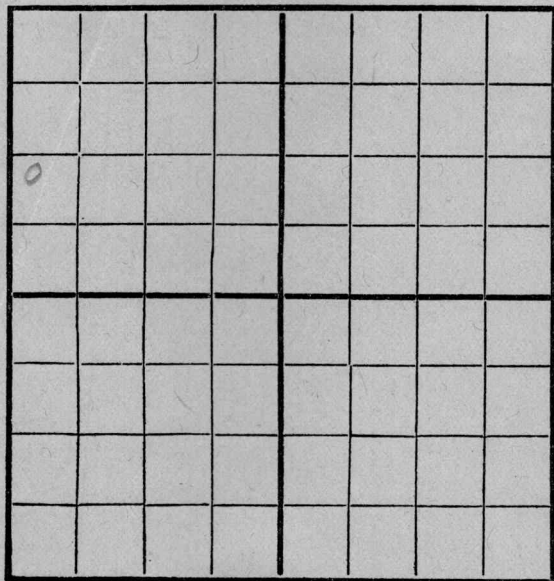

EAST

SOUTH

Location _____

Rig Up _____

Drilling and remarks

1440

RECORD

Cased _____ in. _____ Ft.

Sand _____

Gas _____

Oil _____

Total Depth _____

PRODUCTION

1st 24 hrs. Nat. _____

1st 24 hrs. after shot _____

Gas _____ Cu. Ft.

Dry Hole _____

Abandoned _____


Date

9/12, 1916 Scout

Map No. _____ Sec. 15 Twp. 28 R. 4Well No. 61 Brown Farm _____Monroe Company _____

NORTH

WEST

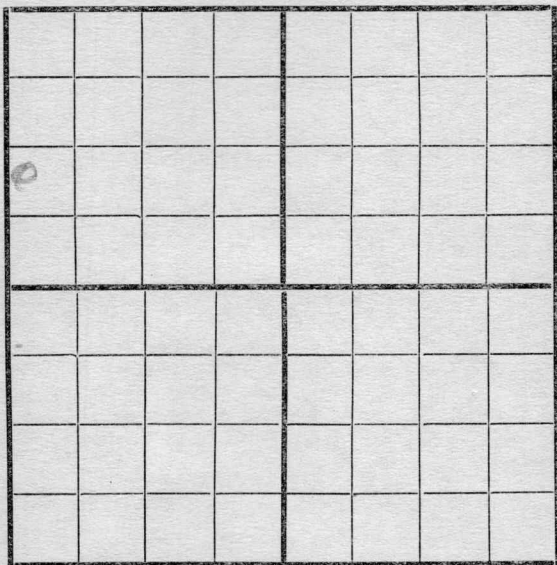

EAST

SOUTH

Location _____

Rig Up _____

Drilling and remarks

1780

RECORD

Cased _____ in. _____ Ft.

Sand _____

Gas _____

Oil _____

Total Depth _____

PRODUCTION

1st 24 hrs. Nat. _____

1st 24 hrs. after shot _____

Gas _____ Cu. Ft.

Dry Hole _____

Abandoned _____

Date

9/18 191 6 Alley Scout

Map No. _____ Sec. 15 Twp. 28 R. 4
Well No. 6 Brown Farm _____
Monitor Company _____

NORTH

WEST

EAST

SOUTH

Location _____

Rig Up-----

Drilling and remarks

RECORD

Cased _____ in. _____ Ft.

Sand _____

Gas -----

Oil _____

Total Depth.....

PRODUCTION

1st 24 hrs. Nat.-----

First 24 hrs. after shot-----

Gas----- Cu. Ft

Dry Hole.....


Abandoned_ _ _ _ _

Date _____

Date 7/27, 1916. Ala. La. La. Scout

Map No. _____ Sec. 15 Twp. 28 R. 4
 Well No. 6 Brown Farm _____
Union Company _____

NORTH

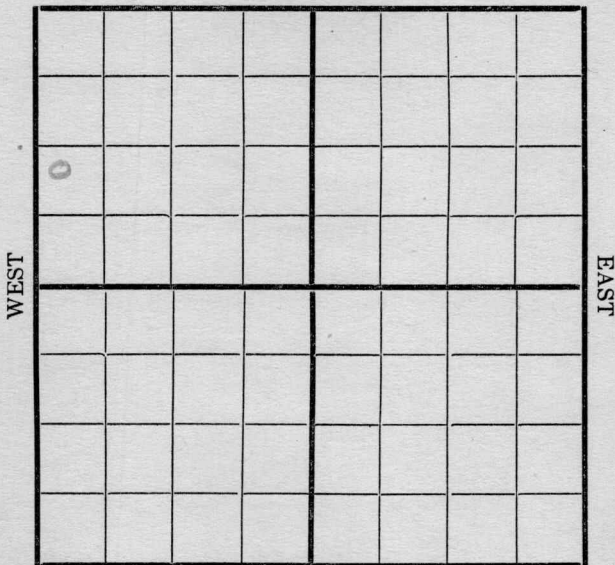

SOUTH

Location _____
 Rig Up _____
 Drilling and remarks

2260

RECORD

Cased _____ in. _____ Ft.
 Sand _____
 Gas _____
 Oil _____
 Total Depth _____

PRODUCTION


1st 24 hrs. Nat. _____
 1st 24 hrs. after shot _____
 Gas _____ Cu. Ft.
 Dry Hole _____
 Abandoned _____

Date 10/6/00 191 _____ Scout

Map No. _____ Sec. 15 Twp. 38 R. 4
 Well No. 6 Brown Farm _____
Monitor Company _____

NORTH

WEST

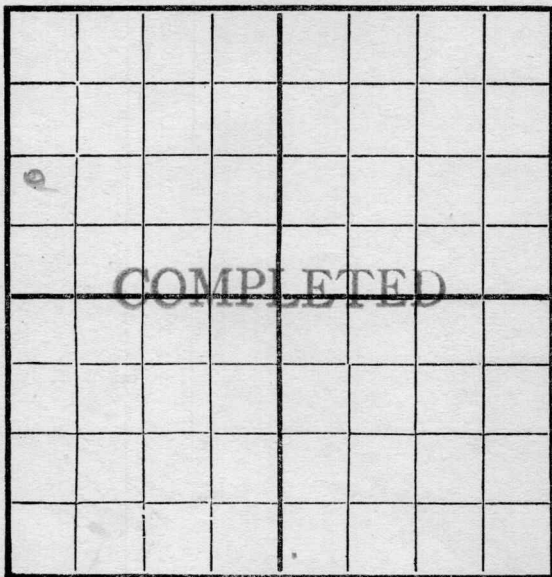

EAST

SOUTH

Location _____
 Rig Up _____
 Drilling and remarks _____

Est good
for 350 bbl

RECORD

Cased _____ in. _____ Ft.
 Sand 2523-2543
 Gas _____
 Oil _____
 Total Depth _____

PRODUCTION

1st 24 hrs. Nat. _____
 First 24 hrs. after shot _____
 Gas _____ Cu. Ft.
 Dry Hole _____
 Abandoned _____

Date 10/12, 1916 McCord Scout