


Map No. _____ Sec. 15 Twp. 28 R. 4
 Well No. 1- Purcell Farm _____
Mich-Kansas Company _____

NORTH

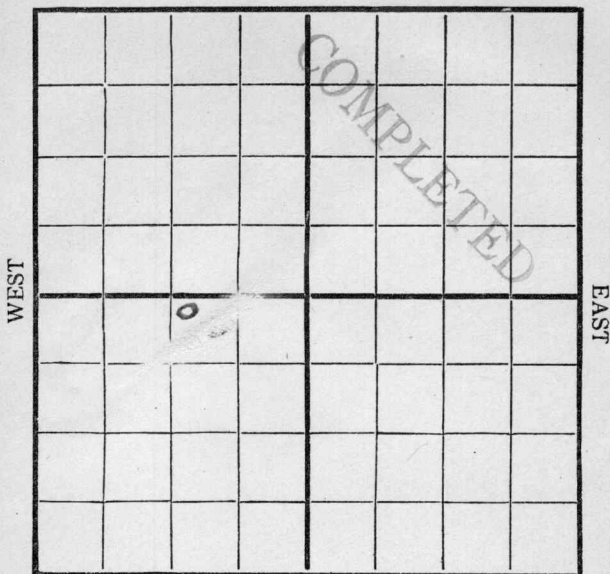

SOUTH

Location _____

Rig Up _____

Drilling Remarks:

Drilling Remarks:

6/30 2603-2621 3086

RECORD

Cased _____ in _____ Ft.
 Sand _____
 Gas _____
 Oil _____
 Total Depth _____


PRODUCTION

1st 24 hrs. Nat. _____
 1st 24 hrs. after shot _____
 Gas _____ Cu. Ft.
 Dry Hole _____
 Abandoned _____

Map No. _____ Sec. 15 Twp. 28 R. 4
 Well No. 1 P Russell Farm _____
Mid Kansas Company _____

NORTH

WEST

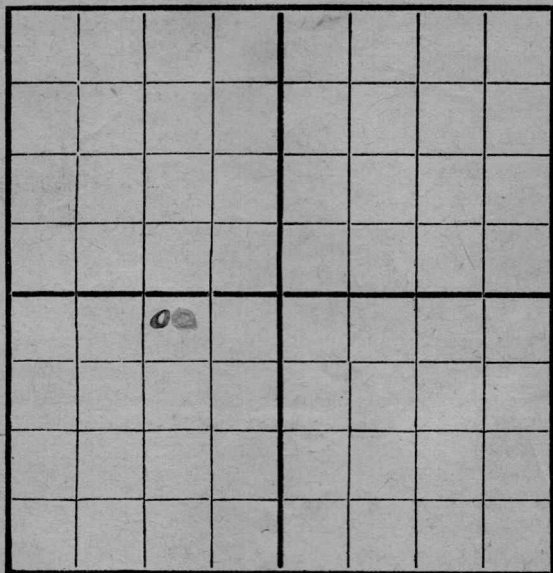

EAST

SOUTH

Location _____

Rig Up _____

Drilling and remarks

30 bbl well

RECORD

Cased _____ in. _____ Ft.

Sand 2603-2621

Gas _____

Oil _____

Total Depth _____

PRODUCTION

1st 24 hrs. Nat. _____

1st 24 hrs. after shot _____

Gas _____ Cu. Ft.

Dry Hole _____

Abandoned _____

Date

6/20, 1916 L. B. Smith Scout