

Section 34 Township 23 Range 14EWell No. 1 HomesCompany Bennett & Abel

Misc.

NORTH

|  |  |  |  |  |   |  |  |
|--|--|--|--|--|---|--|--|
|  |  |  |  |  |   |  |  |
|  |  |  |  |  |   |  |  |
|  |  |  |  |  | 0 |  |  |
|  |  |  |  |  |   |  |  |
|  |  |  |  |  |   |  |  |
|  |  |  |  |  |   |  |  |
|  |  |  |  |  |   |  |  |
|  |  |  |  |  |   |  |  |

WEST

EAST

SOUTH

Sec. 34 Twp. 23 R. 14E ✓

Well No. 1 Homes Farm

Bennett & Abel Company

Misc.


           Ft. from N. Line

990 Ft. from S. Line

           Ft. from E. Line

320 Ft. from W. Line

NE SW NE

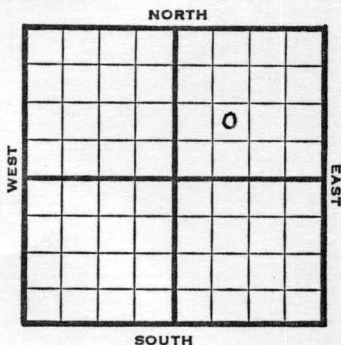

1948

R E P O R T

9/22 12" @ 550  
Drilling 645'

9/29 Drlg. 900'

10/6 10" @ 515'  
8" @ 1001'  
1045 SD repairs

10/13 Drlg. 1550'

10/19 Mississippi 1681'  
6" @ 1621'

10/26 500 acid

11/3 TD 1704'

11/10 TD 1704'  
Miss 1681'  
Aband.

**ABANDONED**

Woodson County Kansas StateMap No. \_\_\_\_\_ Sec. 34 Twp. 23 R. 14EWell No. 1 HomesBennett & Abel CompanyFIRST REPORT Contractor

NE SW NE

## SECTION PLAT

|  |  |  |  |  |  |  |  |
|--|--|--|--|--|--|--|--|
|  |  |  |  |  |  |  |  |
|  |  |  |  |  |  |  |  |
\_\_\_\_\_ Ft. from N. Line

990 Ft. from S. Line

\_\_\_\_\_ Ft. from E. Line

320 Ft. from W. LineMiscellaneous

Remarks:

12" @ 550 drlg. 645

Date  
SEP 22 1948Scout  
S. J. LEWIS

Kansas

Map No. 17 Sec. 34 Twp. 23 R. 14EWell No. 1 HomesBennett & Abel CompanyABANDONED Contractor

NE SW NE.

## SECTION PLAT

       Ft. from N. Line990 Ft. from S. Line       Ft. from E. Line330 Ft. from W. Line

|  |  |  |  |
|--|--|--|--|
|  |  |  |  |
|  |  |  |  |
|  |  |  |  |
|  |  |  |  |

Woodson County

Location                     Rig up                     

Drilling and Remarks:

*Miss 1681*

## RECORD

Cased            in.,            ft.Sand                     Gas                     Oil                     Total Depth 1204

## PRODUCTION

1st 24 hrs. Nat.                     1st 24 hrs. after shot                     Gas                      Cu. Ft.Dry Hole                     Abandoned                     

Date

NOV 10 1948 19 S. J. LEWIS Scout