

KANSAS
KANSAS

Woodson

Section 34 Township 23 Range 14E

Well No. 5 Ryser


Company Geo. Emery Inc.

Misc.

NORTH

WEST

EAST

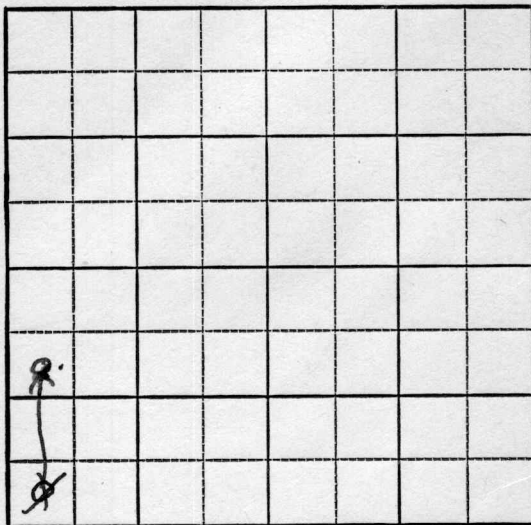

SOUTH

KANSAS

Woodson

Sec. 34 Twp. 23 R. 14E

Well No. #5 Ryser Farm

Geo. Emery, Inc. Company

Miscellaneous


990' Ft. from N. Line

 Ft. from S. Line

 Ft. from E. Line

330' Ft. from W. Line

SW NW SW

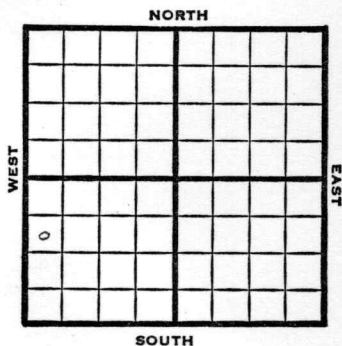

1949 Elev. - REPORT

1/19 8" @ 60'
Miss 1661'
TD 1662'
5" @ 1661'
1/26 "
2/2 "
2/9 "
2/16 Miss 1661'
5" @ 1661'
Pump 40 oil Pot.
Gr. 380
TD 1672'

COMPLETED

Map No. _____ Sec. 34 Twp. 23 R. 14E

Well No. 5 Ryser

Geo. Emery Inc. Company

FIRST REPORT Contractor

SW NW SW


SECTION PLAT

990 Ft. from N. Line

_____ Ft. from S. Line

_____ Ft. from E. Line

3300 Ft. from W. Line

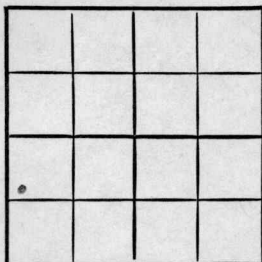

Woodson County

Location _____

Rig up _____

Drilling and Remarks:

8" @ 60

Miss. 1661

TD 1662

5" @ 1661

RECORD

Cased _____ in., _____ ft.

Sand _____

Gas _____

Oil _____

Total Depth _____

PRODUCTION

1st 24 hrs. Nat. _____

1st 24 hrs. after shot _____

Gas _____ Cu. Ft.

Dry Hole _____

Abandoned _____

Date

JAN 19 1949

19

S. J. LEWIS

Scout

Kansas

Miscellaneous

Map No. K17 Sec. 34 Twp. 23 R. 14EWell No. 5 Ryser

Geo. Emery Inc.

Company

COMPLETE

Contractor

SW NW SW

SECTION PLAT

990 Ft. from N. Line Ft. from S. Line Ft. from E. Line330 Ft. from W. Line

0			

Woodson County

Location Rig up

Drilling and Remarks:

*Miss 1661**5" C 1661**Pump 400 oil**88-1/2*

RECORD

Cased in., ft.Sand Gas Oil Total Depth 1672

PRODUCTION

1st 24 hrs. Nat. 1st 24 hrs. after shot Gas Cu. Ft.Dry Hole Abandoned

Date

FEB 16 1949

19

S. J. LEWIS

Scout