


Well No. 1 - Arnold

Company, Braden & Aikman

NORTH

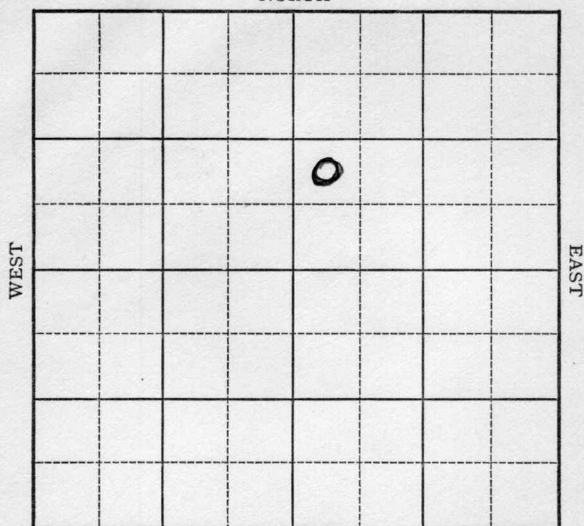

SOUTH

Woodson **KANSAS**Map No. 17 Sec. 35 Twp. 23 R. 14 ^EWell No. 1 - ArnoldBraden & Aikman Company

Contractor

FIRST REPORT

SECTION PLAT

		0	

_____ Ft. from N. Line

490 Ft. from S. Line

_____ Ft. from E. Line

350 Ft. from W. Line

Location _____

Rig up _____

Drilling and Remarks:

Spud

RECORD

Cased _____ in., _____ ft.

Sand _____

Gas _____

Oil _____

Total Depth _____

PRODUCTION

1st 24 hrs. Nat. _____

1st 24 hrs. after shot _____

Gas _____ Cu. Ft.

Dry Hole _____

Abandoned _____

Date

AUG 4 - 1937

19

H. D. Hatfield

Scout

KANSAS

Hoodson

Map No. 17 Sec. 35 Twp. 23 R. 14 EWell No. 1 - ArnoldBraden & Aikman Company

Contractor

COMPLETED

SECTION PLAT

		0	

 Ft. from N. Line990 Ft. from S. Line Ft. from E. Line330 Ft. from W. LineLocation Rig up

Drilling and Remarks:

Got 15 oil
5 water

RECORD

Cased 8 in., 1607 ft.Sand MISS 1607Gas Oil Total Depth 1623

PRODUCTION

1st 24 hrs. Nat. 1st 24 hrs. after shot Gas Cu. Ft.Dry Hole Abandoned

Date

AUG 25 1937 19

H. D. Hatfield Scout