

KANSAS

Woodson


Section 34 Township 23 Range 14EWell No. 1 WestlakeCompany Geo. Emery Inc.

Misc.

NORTH

WEST

EAST

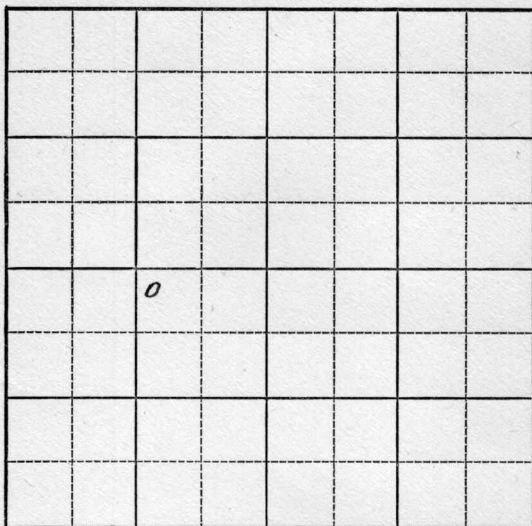

SOUTH

KANSAS

Woodson

Sec. 34 Twp. 23 R. 14E ✓

Well No. #1 Westlake Farm

Geo. Emery, Inc. Company

Miscellaneous (Sunflower, Cont.)

200'

Ft. from N. Line


Ft. from S. Line

1120'

Ft. from E. Line

Ft. from W. Line

NW NE SW

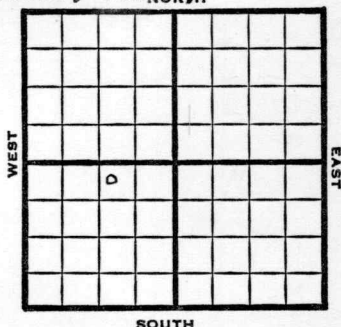

1949

Elev. -

REPORT

6/1

8" @ 60'
Dr1g. 1410'

6/7

Miss 1668
4" @ 1668'
TD 1679'
550' oil 2 hrs.

6/15

"

6/22

Miss 1668'
4" @ 1668'
Acid 1000
Pump 100 oil Pot.
Gr. 38°
TD 1679'

COMPLETED

Map No. _____ Sec. 34 Twp. 23 R. 14E

Well No. 1 Westlake

Geo. Emery Inc. Company

Sunflower Contractor

NW NE SW


FIRST REPORT
SECTION PLAT

200 Ft. from N. Line

_____ Ft. from S. Line

1120 Ft. from E. Line

_____ Ft. from W. Line

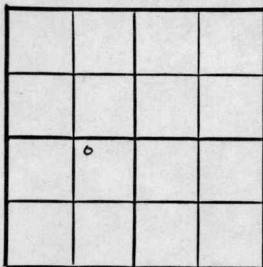

Woodson County

Location _____

Rig up _____

Drilling and Remarks:

8" @ 60

drlg. 1410

RECORD

Cased _____ in., _____ ft.

Sand _____

Gas _____

Oil _____

Total Depth _____

PRODUCTION

1st 24 hrs. Nat. _____

1st 24 hrs. after shot _____

Gas _____ Cu. Ft.

Dry Hole _____

Abandoned _____

Date

JUN 1 1949 19

S. J. LEWIS

Scout

Map No. K17 Sec. 34 Twp. 23 R. 14E

Well No. 1 Westlake

Geo. Emery Inc.

Company

COMPLETE

Contractor

NW NE SW


SECTION PLAT

200 Ft. from N. Line

Ft. from S. Line

Ft. from E. Line

1120 Ft. from W. Line

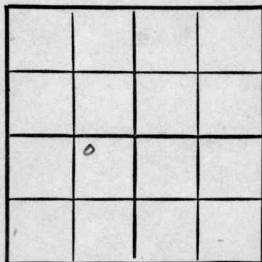

Woodson County

RECORD

Location

Cased _____ in., _____ ft.

Rig up

Sand

Drilling and Remarks:

Gas

Oil

Total Depth 1679

PRODUCTION

1st 24 hrs. Nat. _____

1st 24 hrs. after shot _____

Gas _____ Cu. Ft.

Dry Hole _____

Abandoned _____

Date

JUN 22 1949

19

S. J. LEWIS

Scout