

KANSAS

Woodson

Section 34 Township 23 Range 14-EWell No. #3 WestlakeCompany Geo. Emery Inc.

Misc.

NORTH

WEST

EAST

			0				

SOUTH

KANSAS

Woodson

Sec. 34 Twp. 23 R. 14E ✓

Well No. 3 Westlake Farm

Geo. Emery Inc. Company

Misc.


330 Ft. from N. Line

 Ft. from S. Line

330 Ft. from E. Line

 Ft. from W. Line

NE SW

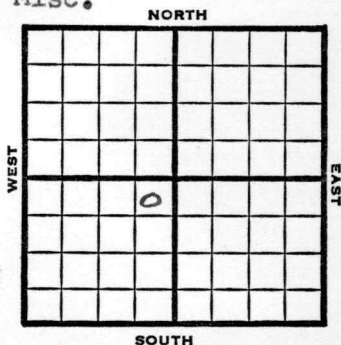

1949

REPORT

7/27

RUR

8/3

Miss 1671'

8" @ 28'

TD 1671'

5" @ 1676'

8/10

TD 1695' - 50 qts.

8/17

TD 1695'

Miss 1676'

5" @ 1671'

50 qts

2000 acid

Pump 15 Oil Pot

38° Gr.

Comp

COMPLETED

Kansas

Miscellaneous

Map No. _____ Sec. 34 Twp. 23 R. 14EWell No. 3 Westlake

Geo. Emery Inc. _____ Company

Contractor

NE SW

FIRST REPORT
SECTION PLAT

330 Ft. from N. Line

_____ Ft. from S. Line

330 Ft. from E. Line

_____ Ft. from W. Line

Woodson County

Location _____

Rig up _____

Drilling and Remarks:

R U R

RECORD

Cased _____ in., _____ ft.

Sand _____

Gas _____

Oil _____

Total Depth _____

PRODUCTION

1st 24 hrs. Nat. _____

1st 24 hrs. after shot _____

Gas _____ Cu. Ft.

Dry Hole _____

Abandoned _____

Date

JUL 27 1949 19S. J. LEWIS Scout

Kansas

Map No. K17 Sec. 34 Twp. 23 R. 14EWell No. 3 Westlake

Geo. Emery Inc.


Company

COMPLETE

Contractor

NE SW

SECTION PLAT

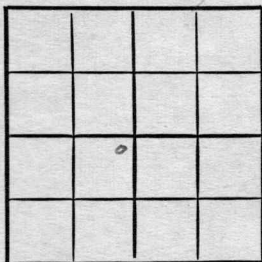330 Ft. from N. Line

Ft. from S. Line

330 Ft. from E. Line

Ft. from W. Line

Woodson County

Location

Rig up

Drilling and Remarks:

*Mis 1676**5' @ 1671**5095**2000 acd**Ping 1500**38 1/2*

RECORD

Cased _____ in., _____ ft.

Sand _____

Gas _____

Oil _____

Total Depth 1695

PRODUCTION

1st 24 hrs. Nat. _____

1st 24 hrs. after shot _____

Gas _____ Cu. Ft.

Dry Hole _____

Abandoned _____

Date

AUG 17 1949 19

S. J. LEWIS Scout