

Section 34 Township 23 Range 14E

Well No. 4 Westlake

Company Geo. Emery

Misc.

NORTH

[illegible]

**SOUTH**

Woodson KANSAS ✓

Sec. 34 Twp. 23 R. 14E

Well No. #4 Westlake Farm

Geo. Emery Company

Miscellaneous

           Ft. from N. Line

200'


           Ft. from S. Line

1080'

           Ft. from E. Line

           Ft. from W. Line

SW SE SW

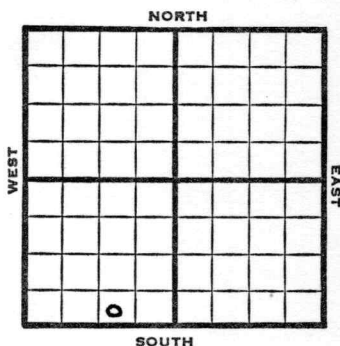

1949

R E P O R T

8/31 Location  
9/7 "  
9/14 Drlg 1500'  
9/21 Miss 1662'  
TD 1692'  
4" @ 1662'  
10/5 Miss 1662'  
4" @ 1662'  
3000 acid  
Pump 3 oil pot  
38.0 Gr.  
TD 1692'  
Comp.

COMPLETED

Map No. \_\_\_\_\_ Sec. 34 Twp. 23 R. 14EWell No. 4 WestlakeGeo. Emery Company

Contractor


SW SE SW

FIRST REPORT  
SECTION PLAT

\_\_\_\_\_ Ft. from N. Line

\_\_\_\_\_ 200 Ft. from S. Line\_\_\_\_\_ 1080 Ft. from E. Line

\_\_\_\_\_ Ft. from W. Line

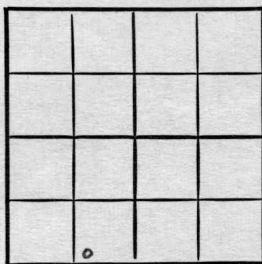

Woodson County

## RECORD

Location x

Cased \_\_\_\_\_ in., \_\_\_\_\_ ft.

Rig up \_\_\_\_\_

Sand \_\_\_\_\_

Drilling and Remarks:

Gas \_\_\_\_\_

Oil \_\_\_\_\_

Total Depth \_\_\_\_\_

## PRODUCTION

1st 24 hrs. Nat. \_\_\_\_\_

1st 24 hrs. after shot \_\_\_\_\_

Gas \_\_\_\_\_ Cu. Ft.

Dry Hole \_\_\_\_\_

Abandoned \_\_\_\_\_

Date

AUG 31 1949 19S. J. LEWIS Scout

Kansas

Miscellaneous

Map No. \_\_\_\_\_ Sec. 34 Twp. 23 R. 14EWell No. 4 Westlake

Geo. Emery

Company

COMPLETE

Contractor

SW SE SW

## SECTION PLAT

|  |  |  |  |
|--|--|--|--|
|  |  |  |  |
|  |  |  |  |
|  |  |  |  |
|  |  |  |  |
|  |  |  |  |

\_\_\_\_\_ Ft. from N. Line

200 Ft. from S. Line1080 Ft. from E. Line

\_\_\_\_\_ Ft. from W. Line

Woodson County

Location \_\_\_\_\_

Rig up \_\_\_\_\_

Drilling and Remarks:

*Miss 1662**4" @ 1662**30000000**Pony soil box**35-4*

## RECORD

Cased \_\_\_\_\_ in., \_\_\_\_\_ ft.

Sand \_\_\_\_\_

Gas \_\_\_\_\_

Oil \_\_\_\_\_

Total Depth 1692

## PRODUCTION

1st 24 hrs. Nat. \_\_\_\_\_

1st 24 hrs. after shot \_\_\_\_\_

Gas \_\_\_\_\_ Cu. Ft.

Dry Hole \_\_\_\_\_

Abandoned \_\_\_\_\_

Date

OCT 5 1949

19

S. J. LEWIS

Scout