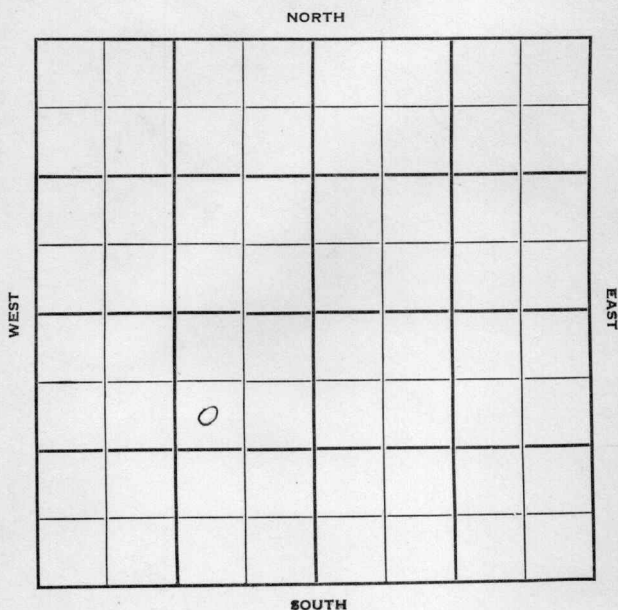


Section 34 Township 23 Range 14EWell No. #5 WestlakeCompany Geo. Emery

Woodson

KANSAS

Sec. 34 Twp. 23 R. 14E

Well No. #5 Westlake Farm

Geo. Emery Company


Miscellaneous Geo. Emery, Contr.

990' Ft. from N. Line

 Ft. from S. Line

990' Ft. from E. Line

 Ft. from W. Line

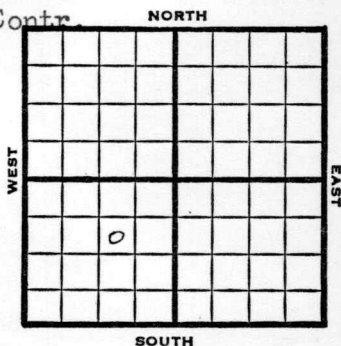

SW NE SW

REPORT

1950

3/29

Bpud 3-27-50
8-5/8" @ 26'
WOC

4/19

TD 1688'
8 5/8" @ 26
Miss 1660-61
4" @ 1661'
Pay 1667-88
Comp 25 bopd
Comp

COMPLETED

Kansas

Map No. _____ Sec. 34 Twp. 23 R. 14EWell No. 5 Westlake

Geo. Emery _____ Company

Geo. Emery _____ Contractor

SW NE SW

990 Ft. from N. Line

_____ Ft. from S. Line

990 Ft. from E. Line

_____ Ft. from W. Line

Woodson County

Location _____

Rig up _____

Drilling and Remarks:

Spud 3-27-50

8 5/8" @ 26

WOC

SECTION PLAT



RECORD

Cased _____ in., _____ ft.

Sand _____

Gas _____

Oil _____

Total Depth _____

PRODUCTION

1st 24 hrs. Nat. _____

1st 24 hrs. after shot _____

Gas _____ Cu. Ft.

Dry Hole _____

Abandoned _____

Date

MAR 29 1950 19

J. E. TYRA Scout

Map No. _____ Sec. 34 Twp. 23 R. 14EWell No. 5 Westlake_____
Geo. Emery _____ Company_____
Contractor

SW NE SW


SECTION PLAT

990 Ft. from N. Line

_____ Ft. from S. Line

990 Ft. from E. Line

_____ Ft. from W. Line

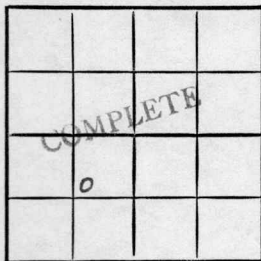

Woodson County

Location _____

Rig up _____

Drilling and Remarks:

8 5/8" @ 26Miss 1660-614" @ 1661Pay 1667-88Comp. 25 bopd

RECORD

Cased _____ in., _____ ft.

Sand _____

Gas _____

Oil _____

Total Depth 1688

PRODUCTION

1st 24 hrs. Nat. _____

1st 24 hrs. after shot _____

Gas _____ Cu. Ft.

Dry Hole _____

Abandoned _____

Date

APR 19 1950

19

J. E. TYRA

Scout