


Section 35 Township 23 Range 11E

Well No. #6 Arnold

Company Aikman & Braden

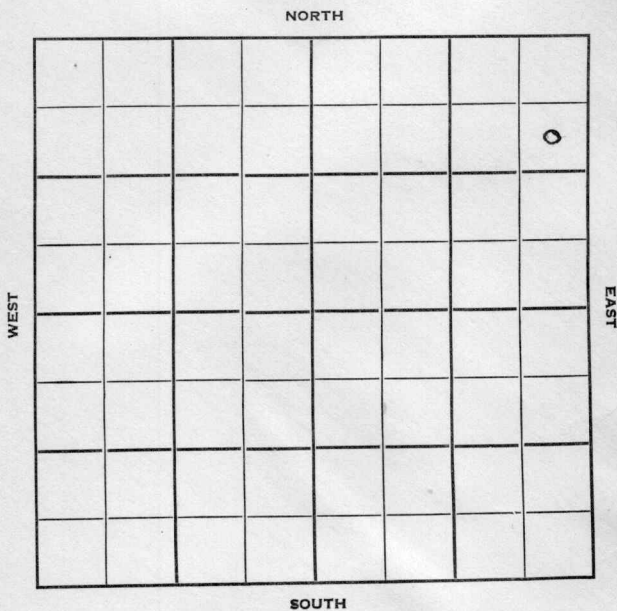

Woodson

KANSAS

35

23

14E

Sec. Twp. R.

#6 Arnold

Well No. Farm

Aikman & Braden

Company

White & Ellis

Contractor

960

Ft. from N. Line


Ft. from S. Line

320

Ft. from E. Line

Ft. from W. Line

SE NE NE

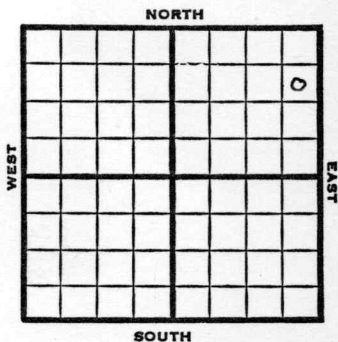

1952

REPORT

10/8

10" @ 85'
Drlg. 1192'

10/29

Oil Well TD 1659'
10" @ 85'
Miss. 1626'
TD 1636'
7" @ 1633' DD 1659
PB 1657
Comp. 12 bopd

COMPLETED

County Woodson State Kansas
 Sec. 35 (Blk.) 23 (Sur.) 14E Map No.

Operator Aikman & Braden

Well No. 6 Farm Arnold

Elev. Location SE NE NE

							0

COMPLETE

960 Ft. From N Line NE

320 Ft. From E Line Quarter

1st. Report

Completion OCT 29 1952

Remarks

White & Ellis - Contr.

Spudding Date

Drlg. Data Oil well TD 1659

10" @ 85 Miss. 1626 TD 1636 7" @ 1633

DD 1659 PB 1657 Comp. 12 bopd

J. G. McGEHEE