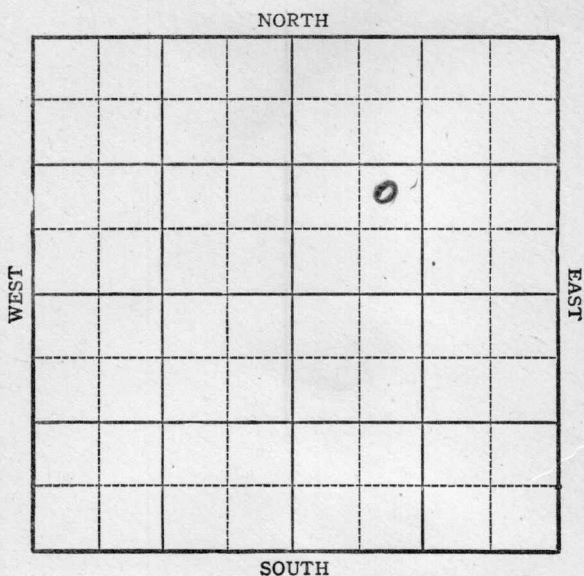


KANSAS

Woodson County

FORM 51 5M BRIX

Section 35 Township 23 Range 14EWell No. #6 ArnoldCompany Aikman & Braden

KANSAS

Woodson County

Sec. 35 Twp. 23S R. 14E

Well No. #6, Arnold Farm

Aikman & Braden Company

Miscellaneous

Ft. from N. Line

990


Ft. from S. Line

Ft. from E. Line

990

Ft. from W. Line

NE SW NE

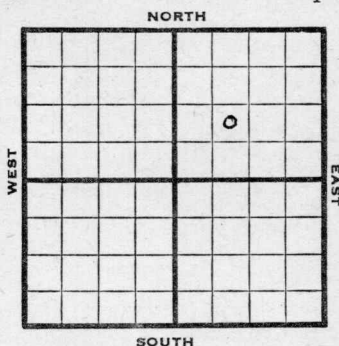

1945

R E P O R T

1-3 Ran 10" @ 812
Drilling 1115'

1/10 Drlg 1420

1/17 8" @ 1305
Miss 1610
oil 1617-21
TD 1628 6-5/8" @ 1615

1/24 Miss. 1610
6" @ 1615
TD 1628
Pump 10 Pot.
Grav. 38.0

COMPLETED

Pool Name MiscellaneousMap No. 17 Sec. 35 Twp. 23 R. 14EWell No. 6 ArnoldAikman & Braden


Company

FIRST REPORT

NE SW NE

Contractor

SECTION PLAT

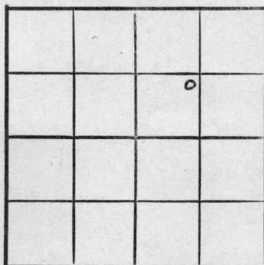Ft. from N. Line990 Ft. from S. LineFt. from E. Line990 Ft. from W. LineWoodson

Location _____

Rig up _____

Drilling and Remarks:

10"-8121115

RÉCORD

Cased _____ in., _____ ft.

Sand _____

Gas _____

Oil _____

Total Depth _____

PRODUCTION

1st 24 hrs. Nat. _____

1st 24 hrs. after shot _____

Gas _____ Cu. Ft.

Dry Hole _____

Abandoned _____

Date

JAN 3 1945 19S. J. LEWIS Scout

Pool Name MiscellaneousMap No. K-17 Sec. 35 Twp. 23 R. 14EWell No. 6 / ArnoldAikman & Braden CompanyCOMPLETED Contractor

NE SW NE

SECTION PLAT

		0	

990 Ft. from N. Line990 Ft. from S. Line990 Ft. from E. Line990 Ft. from W. LineWoodson

Location

Rig up

Drilling and Remarks:

*Mis 1610**6" @ 1615**Pump 10 Rod**380 Gr*

RECORD

Cased _____ in., _____ ft.

Sand _____

Gas _____

Oil _____

Total Depth 1625

PRODUCTION

1st 24 hrs. Nat. _____

1st 24 hrs. after shot _____

Gas _____ Cu. Ft.

Dry Hole _____

Abandoned _____

Date

JAN 24 1945

19

S. J. LEWIS

Scout