


Section 26 Township 23 Range 14-E

Well No. #1 Scales

Company Scales

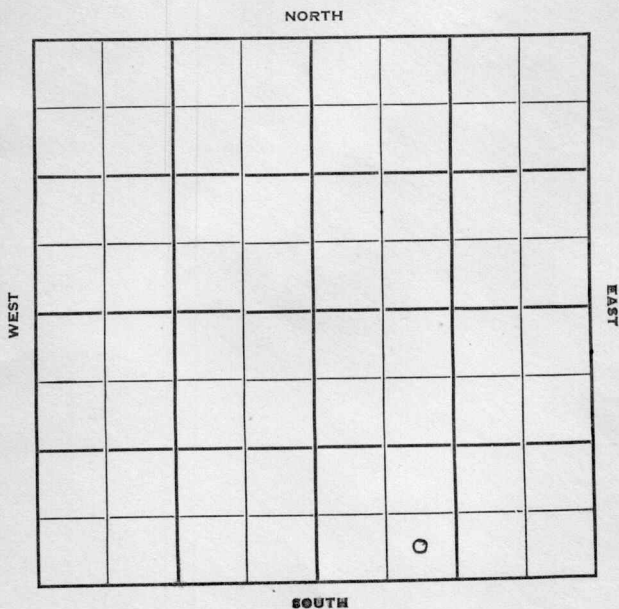

Woodson **KANSAS**

Sec. 26 Twp. 23 R. 14E

Well No. #1 Scales Farm

Scales Company

Contractor


           Ft. from N. Line

330' Ft. from S. Line

           Ft. from E. Line

990' Ft. from W. Line

SE SW SE

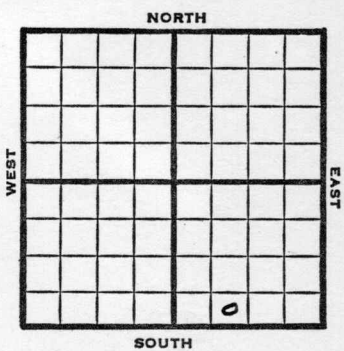

1950

REPORT

8/16 Spud 6-25-50  
TD 1665'  
Miss 1625'  
HFW @ 1660'  
D&A

**FIRST REPORT**  
↓  
**ABANDONED**

