FORM 51 10M 7-48 PETROL


KANSAS Woodson

Section 27 Township 23 Range 14E

Well No. 1 Figge

Company C H Barker et al

Misc.

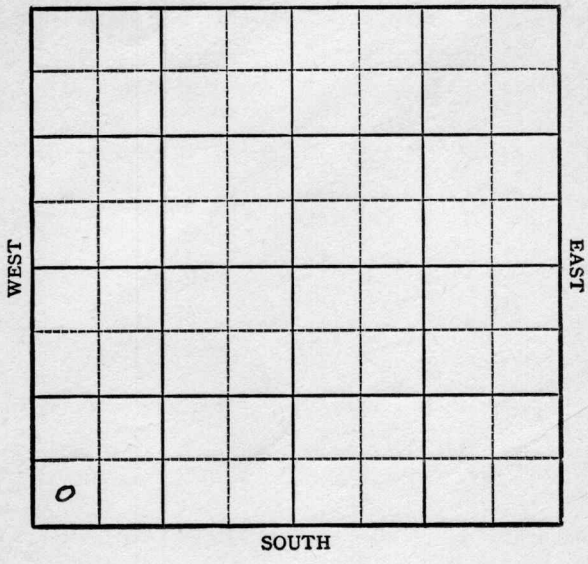

FORM 252-A
5M 10-48 PETROL

KANSAS Woodson

Sec. 27 Twp. 23 R. 14E ✓

Well No. #1 Figge Farm

C. H. Barker et al Company

Miscellaneous


_____ Ft. from N. Line

330' Ft. from S. Line

_____ Ft. from E. Line

330' Ft. from W. Line

SW/C

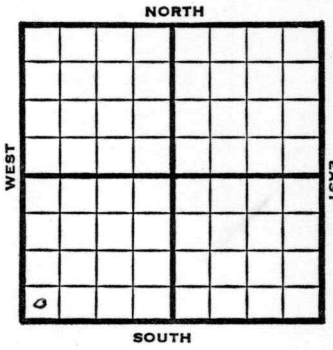

1949	REPORT
1/19	Machine
1/26	Drlg 225'
2/2	SD
2/9	Drlg. 755'
2/16	10" @ 810'
	SD
2/23	"
3/2	Miss 1638'-49' - 600' oil
3/9	TD 1650'
	Miss 1638'
	4"@ 1640
	2000 acid
	Pump 75 Oil Pot
	39° Gr.
	Comp
	COMPLETED

Form 26 200 Bks. 9-48 Petrol

Kansas

Miscellaneous

Map No. _____ Sec. 27 Twp. 23 R. 14E


Well No. 1 Figge

C. H. Barker etal. Company

FIRST REPORT Contractor

SW/C

SECTION PLAT

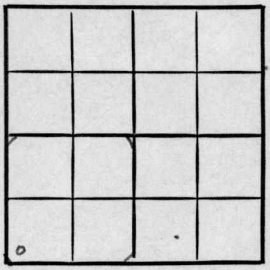

_____ Ft. from N. Line

330 Ft. from S. Line

_____ Ft. from E. Line

330 Ft. from W. Line

Woodson County

Location _____

Rig up _____

Drilling and Remarks:

Machine

RECORD

Cased _____ in., _____ ft.

Sand _____

Gas _____

Oil _____

Total Depth _____

PRODUCTION

1st 24 hrs. Nat. _____

1st 24 hrs. after shot _____

Gas _____ Cu. Ft.

Dry Hole _____

Abandoned _____

Date

JAN 19 1949 19 _____

S. J. LEWIS Scout

Form 26 200 Bks. 9-48 Petrol

Miscellaneous

Kansas

Map No. 17 Sec. 27 Twp. 23 R. 14E


Well No. 1 Figge

C. H. Barker etal. Company

COMPLETE Contractor

SW/C

SECTION PLAT

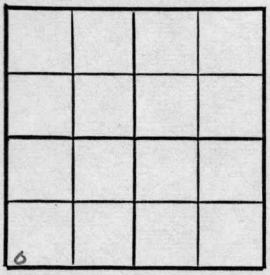

____ Ft. from N. Line

330 Ft. from S. Line

____ Ft. from E. Line

330 Ft. from W. Line

Woodson County

Location

Rig up

Drilling and Remarks:

Miss 1655
4" C/1640
2000 acid
Pump 75 oil Bbl

RECORD

Cased ____ in., ____ ft.

Sand

Gas

Oil

Total Depth 1650

PRODUCTION

1st 24 hrs. Nat.

1st 24 hrs. after shot

Gas ____ Cu. Ft.

Dry Hole

Abandoned

Date

MAR 9 1949 19

S. J. LEWIS Scout