


FORM 51 25M 3-49 PETROL

Section 27 Township 23 Range 14-E

Well No. #1 Figge

Company Westmore Oil
Miscellaneous

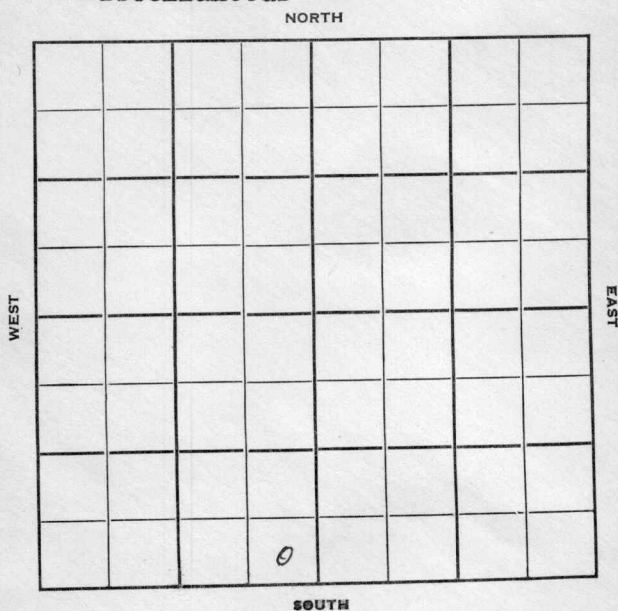

Woodson KANSAS

Sec. 27 Twp. 23 R. 14E

Well No. #1 Figge Farm

Westmore Oil Company

Sunflower Contractor

Miscellaneous


Ft. from N. Line

330' Ft. from S. Line

330' Ft. from E. Line

Ft. from W. Line

SE SW

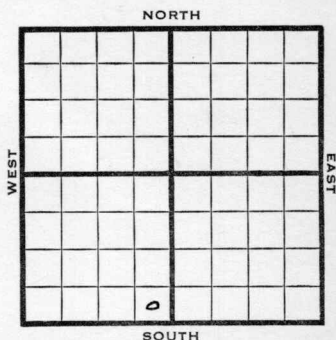

1949	REPORT
10/26	10" @ 21'
	D lg. 650'
11/1	Dr lg 1370'
11/9	Miss 1677'
	52@ 1677'
	TD 1732'
11/16	TD 1732'
	Miss 1677'
	Aband.
	ABANDONED

Map No. _____ Sec. 27 Twp. 23 R. 14EWell No. 1 FigueWestmore Oil CompanySunflower

Contractor


SE SW

FIRST REPORT
SECTION PLAT

_____ Ft. from N. Line

330 Ft. from S. Line330 Ft. from E. Line

_____ Ft. from W. Line

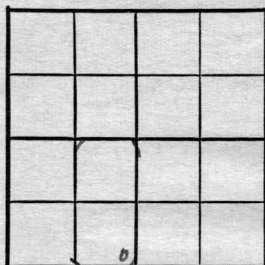Woodson County

Location _____

Rig up _____

Drilling and Remarks:

10" @ 21

drlg. 650

RECORD

Cased _____ in., _____ ft.

Sand _____

Gas _____

Oil _____

Total Depth _____

PRODUCTION

1st 24 hrs. Nat. _____

1st 24 hrs. after shot _____

Gas _____ Cu. Ft.

Dry Hole _____

Abandoned _____

Date

OCT 26 1949 19S. J. LEWIS

Scout

Map No. _____ Sec. 27 Twp. 23 R. 14E

Well No. 1 Figge

Westmore Oil Company

ABANDONED Contractor

SE SW


SECTION PLAT

_____ Ft. from N. Line

330 Ft. from S. Line

330 Ft. from E. Line

_____ Ft. from W. Line

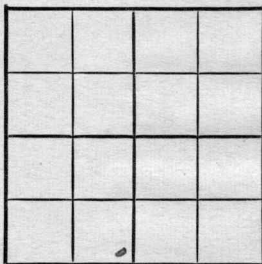

Woodson County

Location _____

Rig up _____

Drilling and Remarks:

Miss 1677

RECORD

Cased _____ in., _____ ft.

Sand _____

Gas _____

Oil _____

Total Depth 1282

PRODUCTION

1st 24 hrs. Nat. _____

1st 24 hrs. after shot _____

Gas _____ Cu. Ft.

Dry Hole _____

Abandoned _____

Date

NOV 16 1949

19

S. J. LEWIS Scout