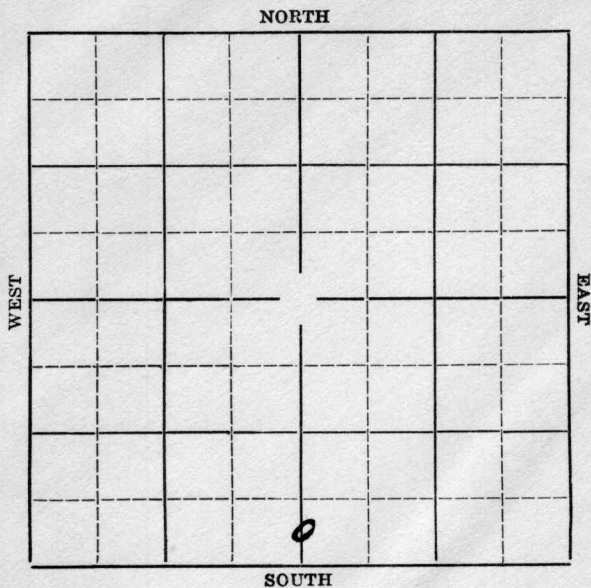


Section 28 Township 23 Range 14-EWell Number 7-FiggoCompany Harper Oil

Woodson

Map No. _____ Sec. **28** Twp. **23** R. **14E**

Well No. #7 Figue Farm


Harper Oil Company

Ft. from N. Line

400' Ft. from S. Line

Ft. from E. Line

2640' Ft. from W. Line

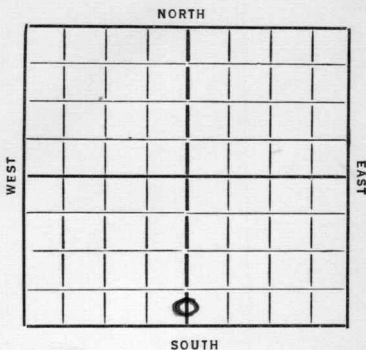

Date
1936

REPORT

6/10 Miss. Lime. 1634'.

Pay 1641-51'.

T.D. 1669'.

~~1660 gallons acid.~~

60 bbls oil.

FIRST REPORTS

and
COMPLETED

Woodson **KANSAS**
 Map No. 17 Sec. 28 Twp. 23 R. 14E

Well No. 7 Figger
Harper Oil Company
 Contractor

SECTION PLAT

_____ Ft. from N. Line

400 Ft. from S. Line

_____ Ft. from E. Line

2640 Ft. from W. Line

FIRST REPORT

COMPLETED

Location _____

Rig up _____

Drilling and Remarks:

Mish 1634
Pay 1641-51
1000 acid
60886

RECORD

Cased _____ in., _____ ft.

Sand _____

Gas _____

Oil _____

Total Depth 1669

PRODUCTION

1st 24 hrs. Nat. _____

1st 24 hrs. after shot _____

Gas _____ Cu. Ft.

Dry Hole _____

Abandoned _____

Date

6/3/36 19

S. J. LEWIS

Scout