
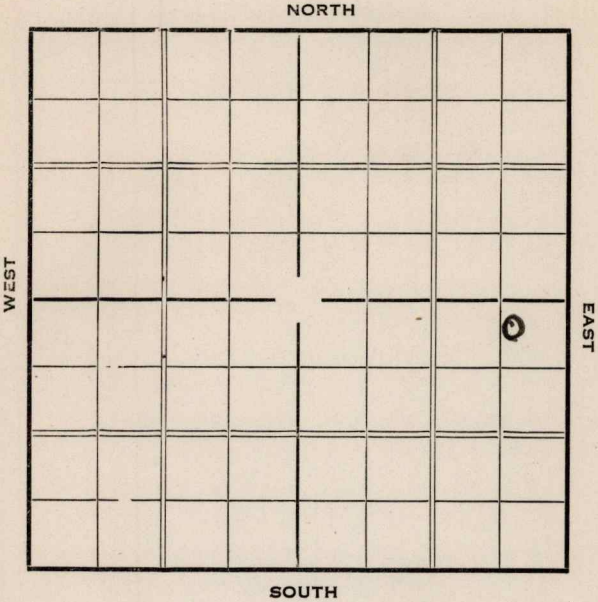


Section 6 Township 24 Range 12-E

Well Number 1 - Davis

Company Polhamus & Markus

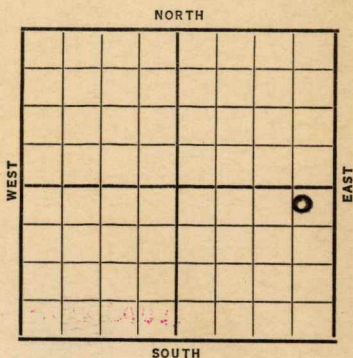

Sec. 6 Twp. 24 R. 12-EWell No. #1 Davis FarmPolhamus & Markus Company300 Ft. from N. Line Ft. from S. Line500 Ft. from E. Line Ft. from W. Line

Date

REPORT

1937

5/5

Location

5/14

Rig'n up

5/21

10" @ 710'. Drlg. 800'.

5/28

8" @ 1430'. Drlg. 1650'.

6/2

Miss. 1798'.

T.D. 1824'. H.F.W.

ABANDONED

KANSAS

Greenwood

Map No. 16 M Sec. 6 Twp. 24 R. 12 EWell No. 1 - DavisPolhamus & Markus Company

Contractor

FIRST REPORT

SECTION PLAT

300 Ft. from N. Line

_____ Ft. from S. Line

500 Ft. from E. Line

_____ Ft. from W. Line

			o

Location ✓

Rig up _____

Drilling and Remarks:

RECORD

Cased _____ in., _____ ft.

Sand _____

Gas _____

Oil _____

Total Depth _____

PRODUCTION

1st 24 hrs. Nat. _____

1st 24 hrs. after shot _____

Gas _____ Cu. Ft.

Dry Hole _____

Abandoned _____

Date

MAY 5 - 1937

19

H. O. Hatfield Scout

KANSAS*Greenwood*Map No. *16^M* Sec. *6* Twp. *24* R. *12^E*Well No. *1 - Davis**Solhamus & Markus* Company

Contractor

ABANDONED

SECTION PLAT

			0

300 Ft. from N. Line

Ft. from S. Line

500 Ft. from E. Line

Ft. from W. Line

RECORD

Location

Cased in., ft.

Rig up

Sand *MISS* *1798*

Drilling and Remarks:

Gas

H.F.W.

Oil

Total Depth *1824*

PRODUCTION

1st 24 hrs. Nat.

1st 24 hrs. after shot

Gas Cu. Ft.

Dry Hole

Abandoned

D & A

Date

JUN 2 1937 19

H. D. Hatfield

Scout