

Company

SOUTH


Drilling Remarks

Abandoned_____

Greenwood

Map No. KANSAS Sec. 6 Twp. 24 R. 12 E
Well No. 3 Davis Farm
Greene & Markue Company

250 Ft. from N. Line
~~970~~ Ft. from S. Line
1070
~~330~~ Ft. from E. Line
Ft. from W. Line

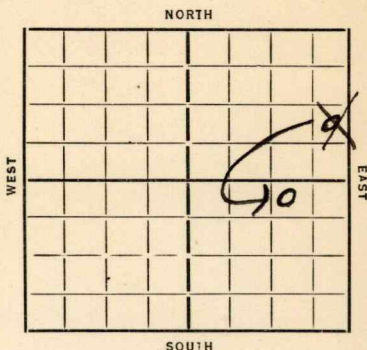

Date 7/9/34

REPORT

10/17 Qty 350
10/25 " 1250
11/1 92 N
11/7 T 1775 D & A

ABANDONED

Map No. 16 Sec. 6 Twp. 24 R. 12EWell No. 3-DavisGore + Markus Company

Contractor

FIRST REPORT SECTION PLAT

____ Ft. from N. Line

990 Ft. from S. Line330 Ft. from E. Line

____ Ft. from W. Line

			0

Location _____

Rig up _____

Drilling and Remarks:

Rel 350

RECORD

Cased _____ in., _____ ft.

Sand _____

Gas _____

Oil _____

Total Depth _____

PRODUCTION

1st 24 hrs. Nat. _____

1st 24 hrs. after shot _____

Gas _____ Cu. Ft.

Dry Hole _____

Abandoned _____

Date

10-17-34 19

ORVAL MANNSCHRECK

Scout

KANSAS

Map No. 16 Sec. 6 Twp. 27 R. 12E


Well No. 3-Davis

Gore + Markus Company

Contractor

CORRECTION

SECTION PLAT

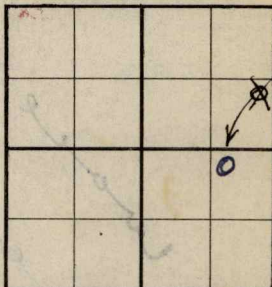

250 Ft. from N. Line

_____ Ft. from S. Line

1070 Ft. from E. Line

_____ Ft. from W. Line

CORRECTION

Location _____

Rig up _____

Drilling and Remarks:

formerly Reported
NW NE SE

RECORD

Cased _____ in., _____ ft.

Sand _____

Gas _____

Oil _____

Total Depth _____

PRODUCTION

1st 24 hrs. Nat. _____

1st 24 hrs. after shot _____

Gas _____ Cu. Ft.

Dry Hole _____

Abandoned _____

Date

10-27-37 19 O. Marnschuch Scout

Map No. 16 Sec. 6 Twp. 24 R. 12 EWell No. 3-HarrisBore & Markus Company

Contractor

ABANDONED

SECTION PLAT

250 Ft. from N. Line

Ft. from S. Line

1070 Ft. from E. Line

Ft. from W. Line

			0

Location

Rig up

Drilling and Remarks:

W & FI

RECORD

Cased in., ft.

Sand

Gas

Oil

Total Depth 1775

PRODUCTION

1st 24 hrs. Nat.

1st 24 hrs. after shot

Gas Cu. Ft.

Dry Hole

Abandoned

Date

11-7-34 192

ORVAL MANNSCHRECK

Scout