

KANSAS

Woodson

Section 28 Township 23 Range 14E

Well No. 12 Figge

Company J E Harper

Misc
NORTH

							0

WEST

EAST

SOUTH

KANSAS

Woodson

Sec. 28 Twp. 23 R. 14E ✓

Well No. #12 Figg Farm

J. E. Harper Company

Miscellaneous


 Ft. from N. Line

330' Ft. from S. Line

330' Ft. from E. Line

 Ft. from W. Line

SE/C

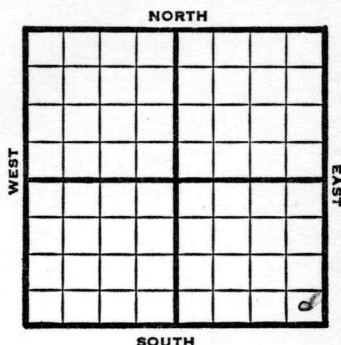

1949

REPORT

3/16	Drlg. 255'
3/23	10" @ 805'
	Drlg 810'
3/30	8" @ 1195'
	Drlg. 1405'
4/6	Miss 1640'
	TD 1650'
	5" @ 1640'
4/12	TD 1652'
	1000' oil
	3000 Acid
4/20	Pump 27 bbls oil & 20 W - 24 hrs.
4/27	"
5/4	"
5/11	TD 1652'
	Miss 1640'
	5" @ 1640'
	3000 acid
	Pump 7 Oil Pot
	38° Gr.
	Comp

COMPLETED

Map No. _____ Sec. 28 Twp. 23 R. 14E

Well No. 12 Figue


J. E. Harper Company

FIRST REPORT

Contractor

SE/C

SECTION PLAT

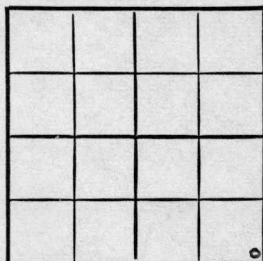

_____ Ft. from N. Line

330 Ft. from S. Line

330 Ft. from E. Line

_____ Ft. from W. Line

Woodson County

RECORD

Location _____

Cased _____ in., _____ ft.

Rig up _____

Sand _____

Drilling and Remarks:

Gas _____

Oil _____

Total Depth _____

drlg. 255

PRODUCTION

1st 24 hrs. Nat. _____

1st 24 hrs. after shot _____

Gas _____ Cu. Ft.

Dry Hole _____

Abandoned _____

Date

MAR 16 1949

19

S. J. LEWIS

Scout

Map No. K17 Sec. 28 Twp. 23 R. 14E

Well No. 12 Figge

J. E. Harper Company

COMPLETE

Contractor

SE/C

SECTION PLAT

 Ft. from N. Line

330

 Ft. from S. Line

330

 Ft. from E. Line

 Ft. from W. Line

Woodson County

RECORD

Location

Rig up

Drilling and Remarks:

Min 1640

5" @ 1640

3000000000

Pump 7 oil BT

38-2-4

Cased in., ft.

Sand

Gas

Oil

Total Depth 1652

PRODUCTION

1st 24 hrs. Nat.

1st 24 hrs. after shot

Gas Cu. Ft.

Dry Hole

Abandoned

Date

MAY 11 1949

19

S. J. LEWIS

Scout