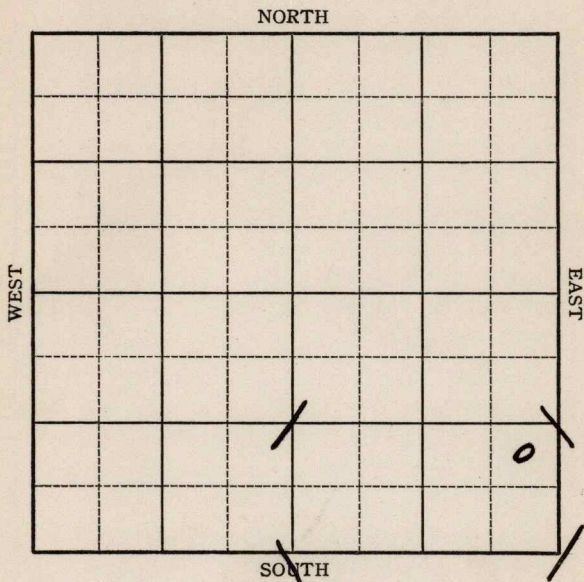
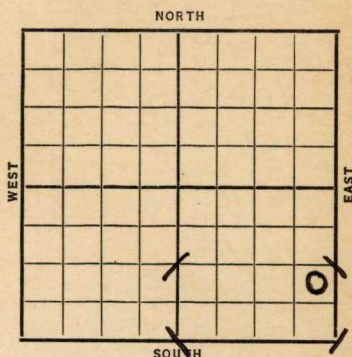


Section 6 Township 24 Range 12-EWell No. 5 - DavisCompany Byke et al

Sec. 6 Twp. 24 R. 12-EWell No. #5 Davis FarmLyke et al Company Ft. from N. Line990 Ft. from S. Line330 Ft. from E. Line Ft. from W. Line

Date

REPORT

1937

6/16 Rig'n Mach.

6/25 " "

7/2 Drlg. 645'.

7/9 10" @ 725'. Drlg. 1370'.

7/14 Miss. 1805'.

T.D. 1850'.

ABANDONED

KANSAS*Greenwood*Map No. *16* Sec. *6* Twp. *24* R. *12 E*Well No. *5 - Davis**Syke et al* Company

Contractor

FIRST REPORT**SECTION PLAT**

_____ Ft. from N. Line

990 Ft. from S. Line*330* Ft. from E. Line

_____ Ft. from W. Line

Location _____

RECORD

Cased _____ in., _____ ft.

Sand _____

Gas _____

Oil _____

Total Depth _____

Drilling and Remarks:

*Rign mach***PRODUCTION**

1st 24 hrs. Nat. _____

1st 24 hrs. after shot _____

Gas _____ Cu. Ft.

Dry Hole _____

Abandoned _____

Date

JUN 16 1937 19

H. D. Hatfield Scout

Greenwood

Map No. *16^M* Sec. *6* Twp. *24* R. *12^E*

Well No. *5-Davis*

Lyke et al Company
Contractor

ABANDONED

SECTION PLAT

			0

_____ Ft. from N. Line

990 Ft. from S. Line

330 Ft. from E. Line

_____ Ft. from W. Line

Location _____

Rig up _____

Drilling and Remarks:

D & A

RECORD

Cased _____ in., _____ ft.

Sand *MISS 1805*

Gas _____

Oil _____

Total Depth *1850*

PRODUCTION

1st 24 hrs. Nat. _____

1st 24 hrs. after shot _____

Gas _____ Cu. Ft.

Dry Hole _____

Abandoned _____

Date

JUL 14 1937 19

H. D. Hatfield Scout