


Section 6 Township 24 Range 12-E

Well No. #1, Fee

Company Davis

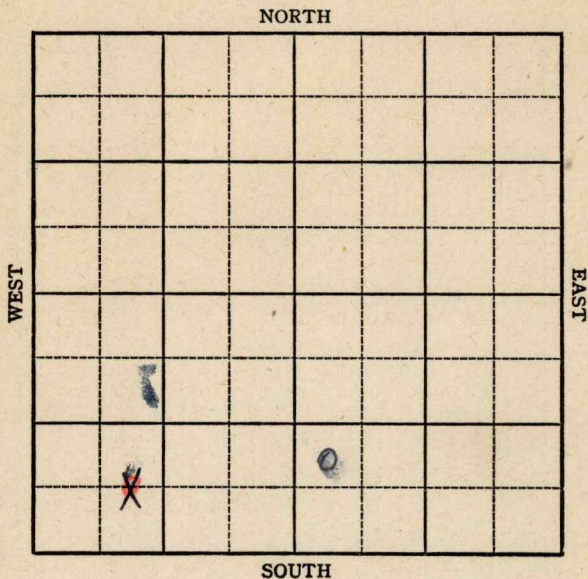

KANSAS

Greenwood county ✓

Sec. 6 Twp. 24 R. 12-E

Well No. #1, Fee Farm _____

Davis Company


Virgil Pool

Ft. from N. Line

990 Ft. from S. Line

Ft. from E. Line

330
990 Ft. from W. Line

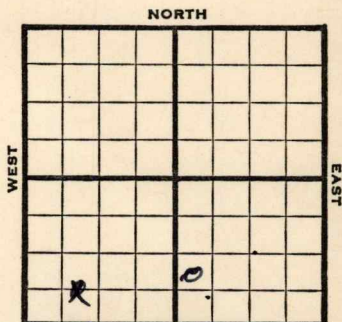

~~SE L SW SW~~ nw sw se

1946

REPORT

12/18 10" @ 690'
Drlg. 765'

1947

1/4 8" @ 1370'
Drlg 1280'

1/8 Drlg 1850'

1/15 SD

1/21 SD

2/12 **Miss 1796**
6" @ 1800
1000 Acid
Pump 10 Pot
Grav. 38'
TD 1815'

COMPLETED

Map No. _____ Sec. 6 Twp. 24 R. 12EWell No. 1 Fee

Davis

Company

FIRST REPORT

Contractor

C E L SW SW

SECTION PLAT

_____ Ft. from N. Line

660

_____ Ft. from S. Line

_____ Ft. from E. Line

990

_____ Ft. from W. Line

Greenwood County

Location _____

Rig up _____

Drilling and Remarks:

10" @ 690

drlg. 765

RECORD

Cased _____ in., _____ ft.

Sand _____

Gas _____

Oil _____

Total Depth _____

PRODUCTION

1st 24 hrs. Nat. _____

1st 24 hrs. after shot _____

Gas _____ Cu. Ft.

Dry Hole _____

Abandoned _____

Date

DEC 1 8 1946 19

S. J. LEWIS

Scout

16

Kansas

KANSAS

Virgil Pool

Map No. 16 Sec. 6 Twp. 24 R. 12EWell No. 1 Fee

Davis


Company

COMPLETE

Contractor

C E L SW SW

SECTION PLAT

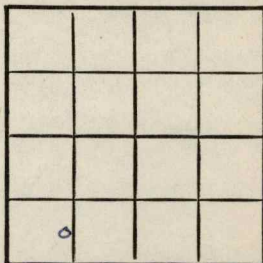

Ft. from N. Line

660

Ft. from S. Line

Ft. from E. Line

990

Ft. from W. Line

Greenwood County

Location

Rig up

Drilling and Remarks:

Miss 1796
6" @ 1800
1000 acid
Pump 10 ft

38° 44'

RECORD

Cased _____ in., _____ ft.

Sand _____

Gas _____

Oil _____

Total Depth 1815

PRODUCTION

1st 24 hrs. Nat. _____

1st 24 hrs. after shot _____

Gas _____ Cu. Ft.

Dry Hole _____

Abandoned _____

Date

FEB 1 2 1947

19

S. J. LEWIS

Scout

Map No. _____ Sec. 6 Twp. 24 R. 12E

Well No. 1 Fee

Davis

Company

CORRECTION

Contractor

NW SW SE

SECTION PLAT

		o	

_____ Ft. from N. Line

990 Ft. from S. Line

_____ Ft. from E. Line

330 Ft. from W. Line

Greenwood County

Location _____

Rig up _____

Drilling and Remarks:

Completed

Feb. 12-47

Reported

C E L SW SW

RECORD

Cased _____ in., _____ ft.

Sand _____

Gas _____

Oil _____

Total Depth _____

PRODUCTION

1st 24 hrs. Nat. _____

1st 24 hrs. after shot _____

Gas _____ Cu. Ft.

Dry Hole _____

Abandoned _____

Date

AUG 17 1949

19

S. J. LEWIS

Scout