


Section 6 Township 24 Range 12^EWell No. ²~~#1~~ RatcliffCompany Hester & Wright Oil

NORTH

WEST

EAST

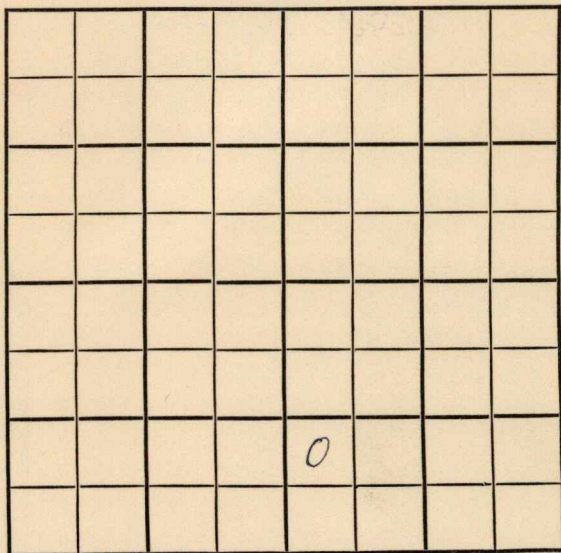

SOUTH

County Greenwood Elev. _____
Sec. 6 Twp. 24 Rge. 12E
Company Heater & Wright Oil
FarmName Ratcliff No. 1

TOPS	DEPTH	LOG	DATUM	Loc. in Sec.
Anh.				NW SW SE
Tr.				
H.				
Tr.				
Dg.				
Bl.				
L.				
K.C.				Geol. _____
B.K.C.				Contr. _____
Ce.				Vernon Baker
C.				Tools
M.				Pool
M.				Hamilton
K.				
Mz.				
Mq.				
V.				
S.				
S.				
A.				
R.				
PE.				
G.				
T.D.				

FIRST REPORT
OCT 24 '56

Date Comm. spd. 10-17-56
10" @ 34, Drlg. 196

NOV 5 1956

R. G. R

Handwritten signature

CORRECTION

FORM 513 SUNRAY

County Greenwood Elev. _____
 Sec. 6 Twp. 24 Rge. 12E
 Company Hester & Wright Oil
 Farm Name Ratcliff No. 12

TOPS	DEPTH	LOG	DATUM	Loc. in Sec.
Anh.				NW SW SE
TP.				250 FWL
H.				1720 FNL of SE
Tr.				
Dg.				
Bl.	<u>Bartl sd 1728-41 S.O.</u>			
L.				Geol.
K.C.				Contr.
B.K.C.				Vernon Baker
Ce.				Tools
C.				Pool
M.	<u>21</u>	<u>1803</u>		Hamilton
M.				
K.				
Mz.				
Me.				
V.				
S.				
S.				
A.				
R.				
PE.				
G.				
TD.	<u>1825</u>			

COMPLETE

Date Comm. spd. 10-17-56

10" @ 34, Drlg. 196

OCT 31 '56

P/T 660

11 687 NOV 7 '56 ✓

NOV 13 '56

NOV 21 '56

5 1/2 @ 1822 FU 1150 oil +
 450' wts 12 hrs est 25
 Bopd + 10 Bwpd.